

October 22, 2012

Chevron Energy Solutions Company A Division of Chevron U.S.A. Inc. 12980 Foster, Suite 400 Overland Park, KS 66213-2649 Tel: 913-748-8800 Fax: 913-748-8734

ADDENDUM – Chevron-1

FROM: Chevron Energy Solutions Company

TO: Prospective Bidders

RE: Addendum – Chevron-1 to Houston Community College – Alief Center Renovation

You are instructed to read and to note the following described changes, corrections, clarifications, approvals, additions, and/or deletions.

Receipt of Addendum - Chevron-1 is to be acknowledged on the bid form by the Bidder.


CHANGES/CLARIFICATIONS

- 1) Owner shall have first right of refusal for all equipment removed from the facility. Bidder shall be responsible for removal and proper disposal of refrigerant. If existing chillers must be disassembled to allow them to be removed from the facility, reassembly is not required.
- 2) There will be lay down area available for the Contractors. It will be located north of the Alief Center parking lot; map is attached at the end of this document. General Contractor shall provide security fence around area shown. Bidder shall be responsible for secure containers as required.
- 3) Existing air-handling units to be replaced that are currently serving occupied areas on the 1st floor include: AHU-1-1, AHU-3-1, AHU-P-1 and AHU-P-2.
- 4) New variable frequency drives shall be provided by Bidder and installed by General Contractor.
- 5) Control valves and control dampers (not provided with AHU) shall be provided by Controls Contractor and installed by Bidder.
- 6) Chiller automatic isolation valves shall be replaced. New valves provided by Controls Contractor and installed by Bidder; existing actuators shall be reused.
- 7) Remove existing balancing valves on existing air-handling units to remain that shall receive new pressure independent control valves, provide and install spool piece as required.
- 8) Refrigerant monitor shall be provided and installed by Bidder. Controls Contractor shall interface with refrigerant monitor and interlock with purge system. Controls Contractor shall also provide and install strobe lights and pull stations/emergency push buttons. Power wiring by General Contractor.



- 9) Fume hoods and fume hood controls shall be provided and installed by Bidder. Controls Contractor shall interface to fume hood controller via BACnet. Point mapping shall be provided by Bidder.
- 10) Cooling tower motors to be provided and installed by Bidder. Electrical by General Contractor.
- 11) Drawings show existing VAV boxes to be locked closed on the 3rd and 4th floor; this work shall be completed by Controls Contractor.
- 12) Roof curbs and penetrations associated with mechanical installation shall be provided and installed by Bidder. Contact HCC Roofing Consultant, Mike Perry 281-633-1258, regarding roofing requirements including warranty.
- 13) Fire protection shall be provided and installed by General Contractor. This shall include any existing fire protection systems that must be removed and replaced or relocated to remove and install equipment.
- 14) Fire dampers shall be provided and installed by Bidder.
- 15) Smoke detectors shall be provided and installed by General Contractor.
- 16) Bidder shall determine means necessary to remove and install equipment. Should existing doors, walls, louvers, etc. need to be removed and replaced, Bidder shall include this work in his/her price. Bidder shall also include roof protection to prevent damage while working on the roof.
- 17) The chilled water tie-ins for the new FCU's serving the north stairwell are not shown on the drawings. New chilled water supply and return piping shall be routed to existing 2" lines from shaft near room "Building Ops 2002". Coordinate exact location with Chevron Construction Manager and Engineer.
- 18) Asbestos abatement shall be by General Contractor.



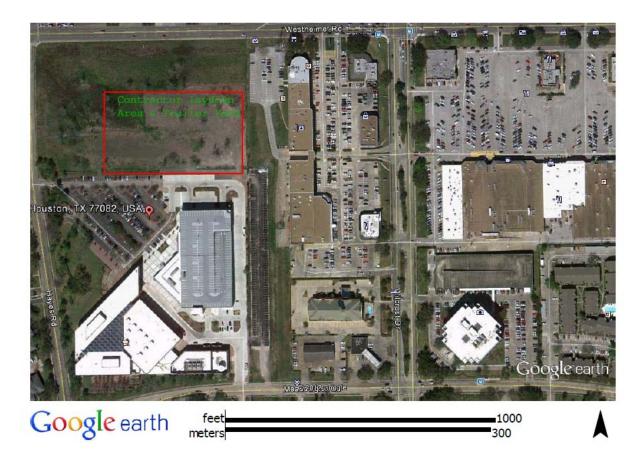



October 29, 2012

Chevron Energy Solutions Company A Division of Chevron U.S.A. Inc. 12980 Foster, Suite 400 Overland Park, KS 66213-2649 Tel: 913-748-8800 Fax: 913-748-8734

ADDENDUM – Chevron-2

FROM: Chevron Energy Solutions Company

TO: Prospective Bidders

RE: Addendum – Chevron-2 to Houston Community College – Alief Center Renovation

You are instructed to read and to note the following described changes, corrections, clarifications, approvals, additions, and/or deletions.

Receipt of Addendum – Chevron-2 is to be acknowledged on the bid form by the Bidder.

CHANGES/CLARIFICATIONS

- 1) Remove Paragraph 2.5.C.5 from Specification Section 23 36 00. Refer to revised fume hood supply and exhaust valve schedules.
- 2) Specification Section 23 05 14 is attached and shall be included in Bid Documents.
- 3) Five (5) existing Liebert units located on the 2nd floor across from the freight elevator shall be removed by Bidder. Remove piping back to valves and provide blind flanges. FM-200 shall be removed by General Contractor.
- 4) Air-handling units that must be broken down and reassembled in the field shall be reassembled per manufacturer's written instructions. All joints shall be caulked and properly sealed. Apply ¼" thick by 1-1/4" wide closed cell neoprene gasketing to all joints. Use commercial grade silicone (indoor use) to seal seams.
- 5) The following changes shall be included in Section 23 64 16, Part 1 GENERAL, Article 1.6 VERIFICATION OF CHILLER CAPACITY AND EFFICIENCY, Paragraph A FACTORY PERORMANCE TEST;

Remove subparagraph 4 and subparagraph 5 and replace with the following: The equipment will be accepted if the test procedures and results are in conformance with AHRI Standard 550/590. If the equipment fails to perform within allowable tolerances, the manufacturer will be allowed to make necessary revisions to his equipment and retest as required. The manufacturer shall assume all expenses incurred by the owner or his representative to witness the request.



Subparagraph 6 Line a, Revise line "a" to read: For each ton below the allowable capacity as set forth in AHRI 550/590 of the design capacity, \$1,000 (one thousand dollars) per ton will be deducted from the contract price.

Subparagraph 6 Line b, Revise line "b" to read: Allowable capacity = $[(1 - \text{tolerance}) \times \text{design capacity}]$; tolerance per AHRI 550/590.


Subparagraph 6 Line c, Add the following to end of line "c": tolerance per AHRI 550/590.

Section 23 64 16, Part 1 GENERAL, Article 1.6 VERIFICATION OF CHILLER CAPACITY AND EFFICIENCY, Paragraph B;

Paragraph B.: Add the following to end of paragraph B: Conduct the performance test in accordance with AHRI Standard 550/590 procedures and tolerances.

Section 23 64 16, Part 1 GENERAL, Article 1.9 WARRANTY, Paragraph B; change "materials" to "materials, labor and refrigerant".


- 6) Section 23 73 13, Part 2 PRODUCTS, Delete Article 2.12 AIRFLOW MEASUREMENT".
- 7) CH-2 and CH-4 have mechanical issues and are not currently operable. One (1) chiller is required to be running to condition the building.
- 8) Bidder shall tie-in chilled water lines for the new FCU's serving the north stairwell per Addendum Chevron-1. This piping originally served two (2) ceiling hung units and has been abandoned. Bidder shall remove abandoned piping.
- 9) Division-1 General Requirements are attached and shall be included in Bid Documents. Specifications available at: <u>http://app.e-builder.net/public/PublicFolderView.aspx?FolderID={9f9ffb87-d872-4f75-9c86-cd331e9cd2e4}</u>. All correspondence from Bidder shall be through Chevron Energy Solutions.
- 10) Bidder shall include a project schedule with his/her bid.
- 11) EF-1 shall be equipped with 2-speed motor.
- 12) ELAP-1 and ELAP-2 shall be rotated 90 degrees, coordinate exact location/orientation with Chevron Energy Solutions Project Manager and Engineer.
- 13) Provide alternate Deduct for Carrier Chillers as substitution for Trane Chillers.
- 14) The following sheets have been revised and are attached: MD.104, M.102, M.103, M.104, M.107, M.401, M.406, M.408 and M.601.

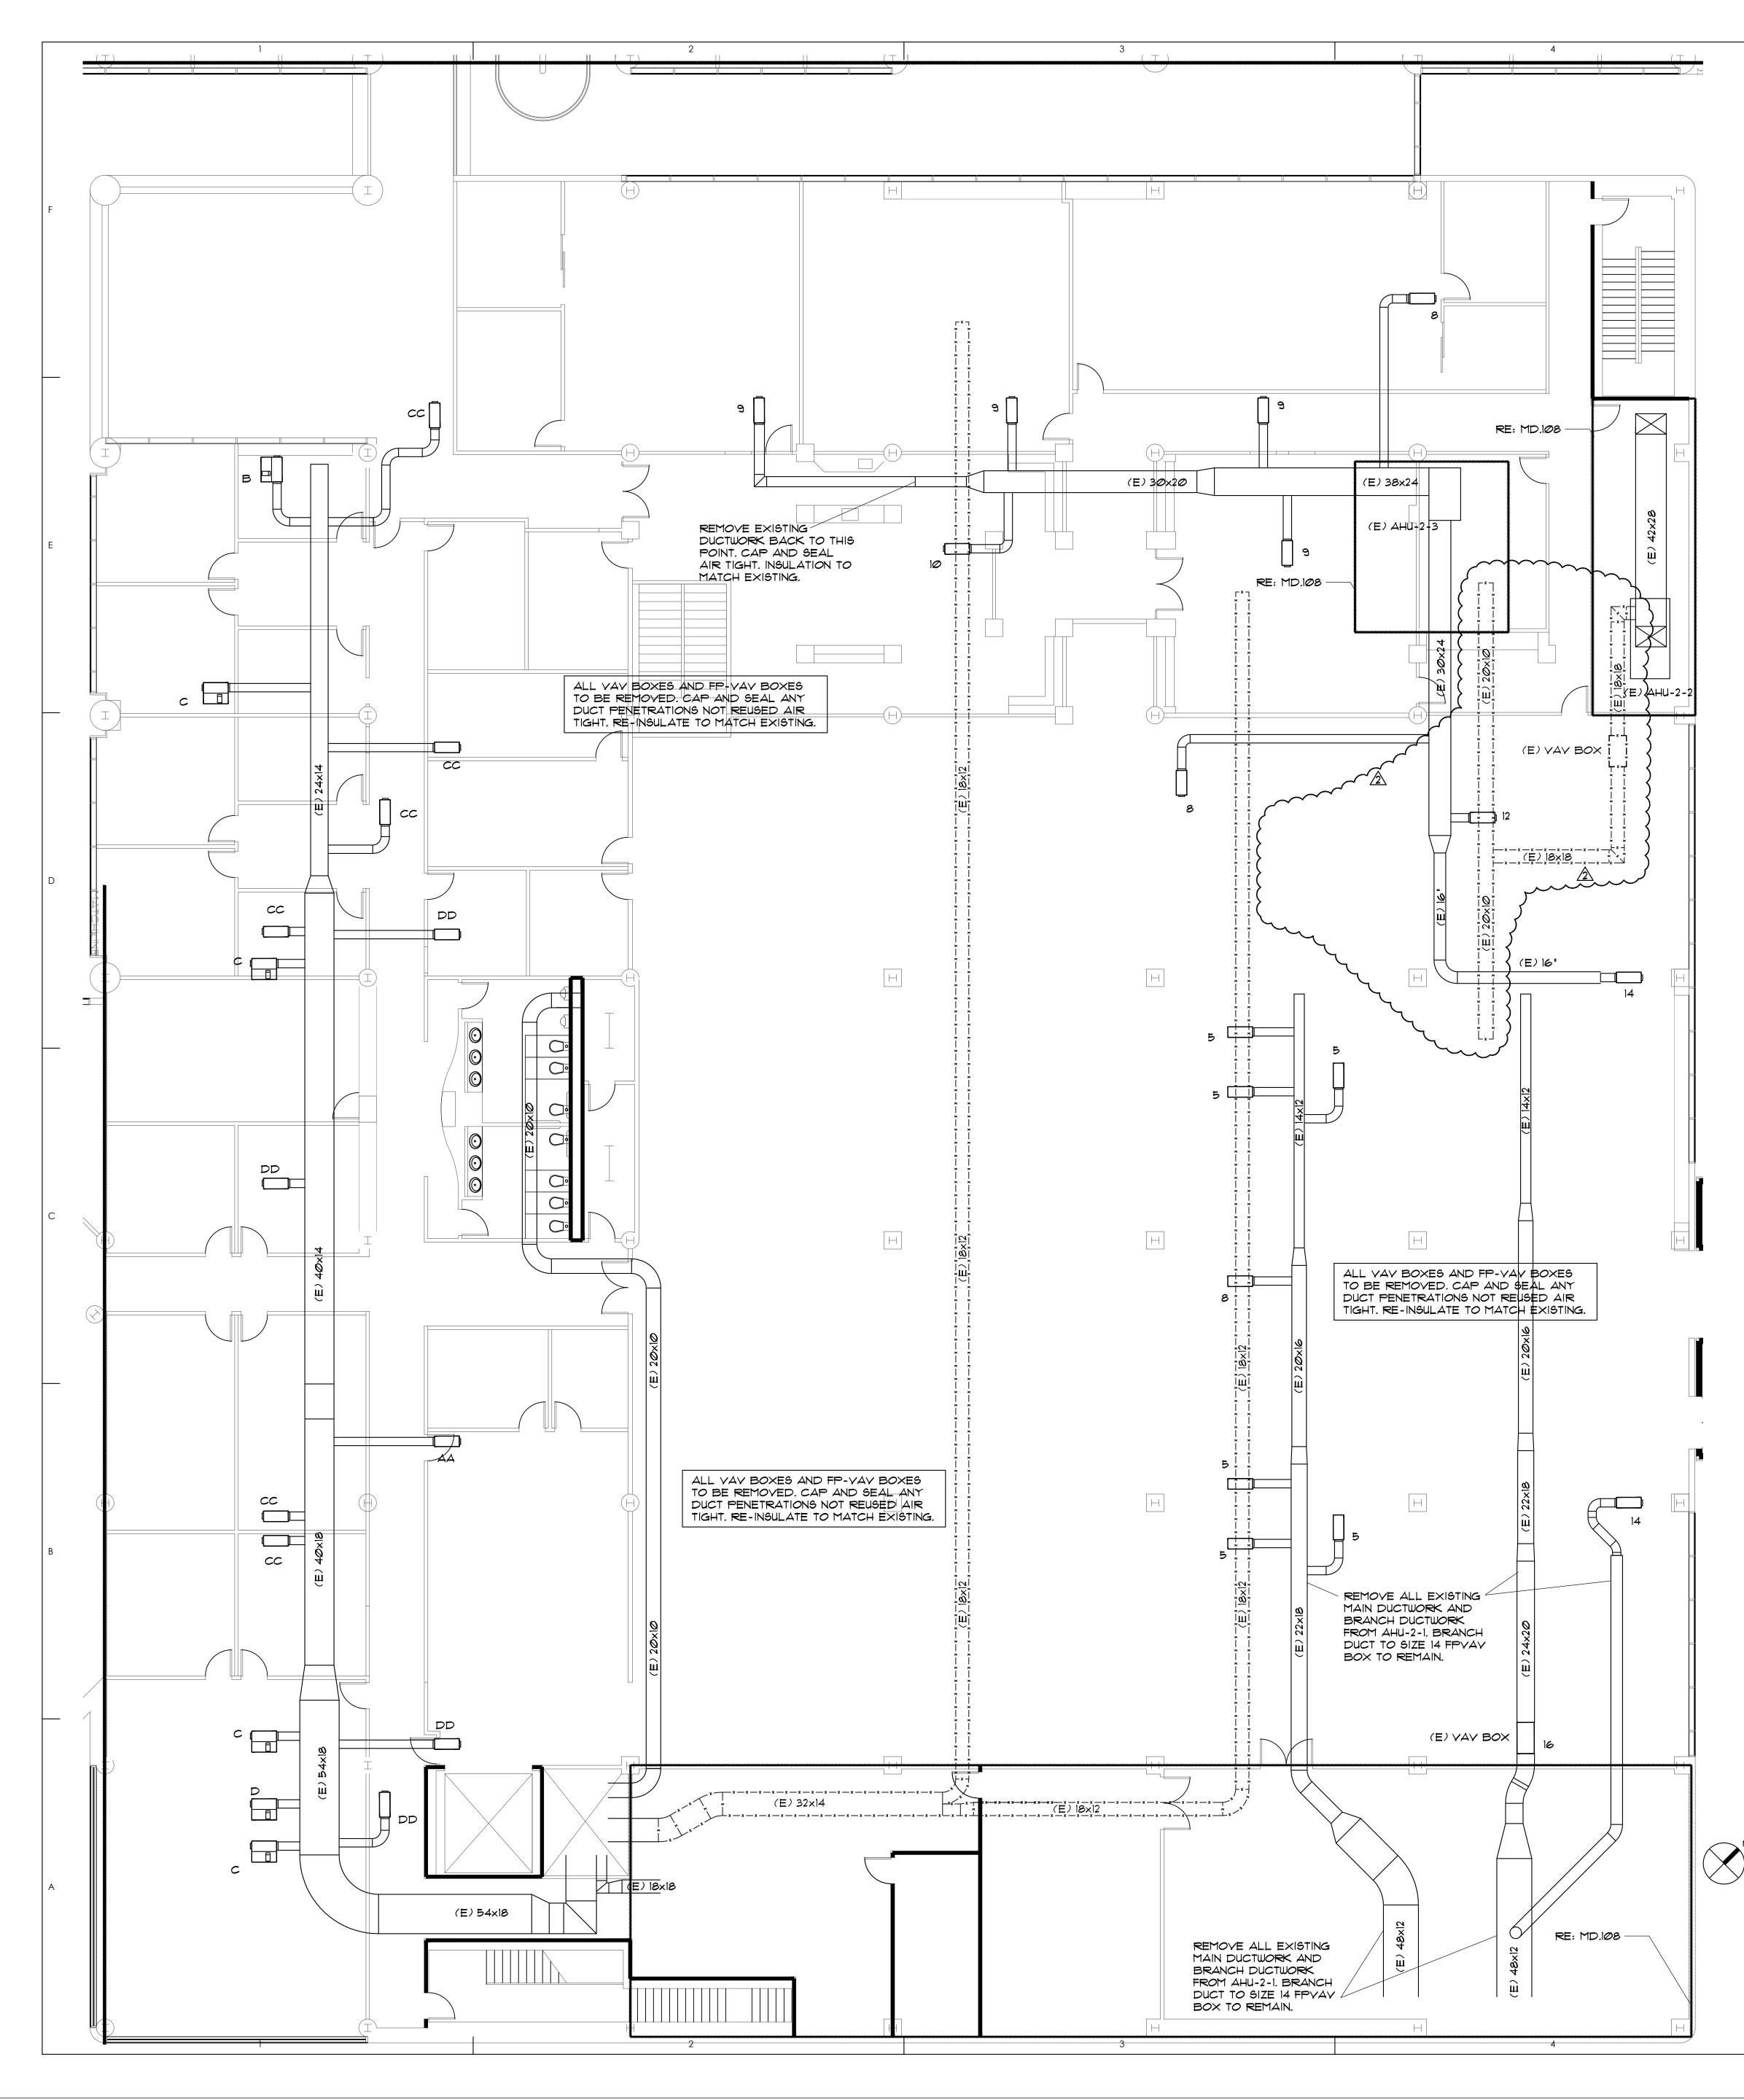

<u>Key Map</u>

6


5

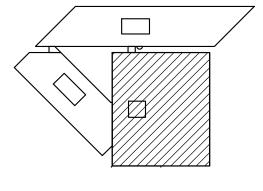



SCALE: 1/8" = 1'-0"




	PROZIGN
	A R C H I T E C T S 701 Shepherd, Suite 200 Houston, TX 77007
F	P (713) 977-6060 F (713) 977-6086 CONSULTANTS:
·	MEP&T: DAWSON VAN ORDEN
	5850 SAN FELIPE ST. SUITE 140 HOUSTON, TX 77057 T 713-266-8984 F 713-266-1238
	CLIENT:
E	2811 Hayes Rd. Houston, TX 77082
D	
С	
_	
	10-25-2012 ADDENDUM NO. CHEVRON 2 2
	10-17-2012 ISSUED FOR BID 10-09-2012 ISSUED FOR PERMIT
В	DELTA# DATE DESCRIPTION PROFESSIONAL SEALS
	JASON W DAWSON 108125
	SONAL ENGINE
	FILENAME DEMO MECHANICAL.dwg
	JOB ABBREV. HCC-UT-ALIEF DRAWN BY RH/MAH CHECKED BY MAH
	JOB NO. 1397 SCALE 1/8" = 1'-0"
	DATE 10-09-2012 ISSUE ISSUED FOR BID SHEET CONTENTS
3 A	2nd FLOOR MECHANICAL DEMOLITION - PART 3
3 A	
3 A	

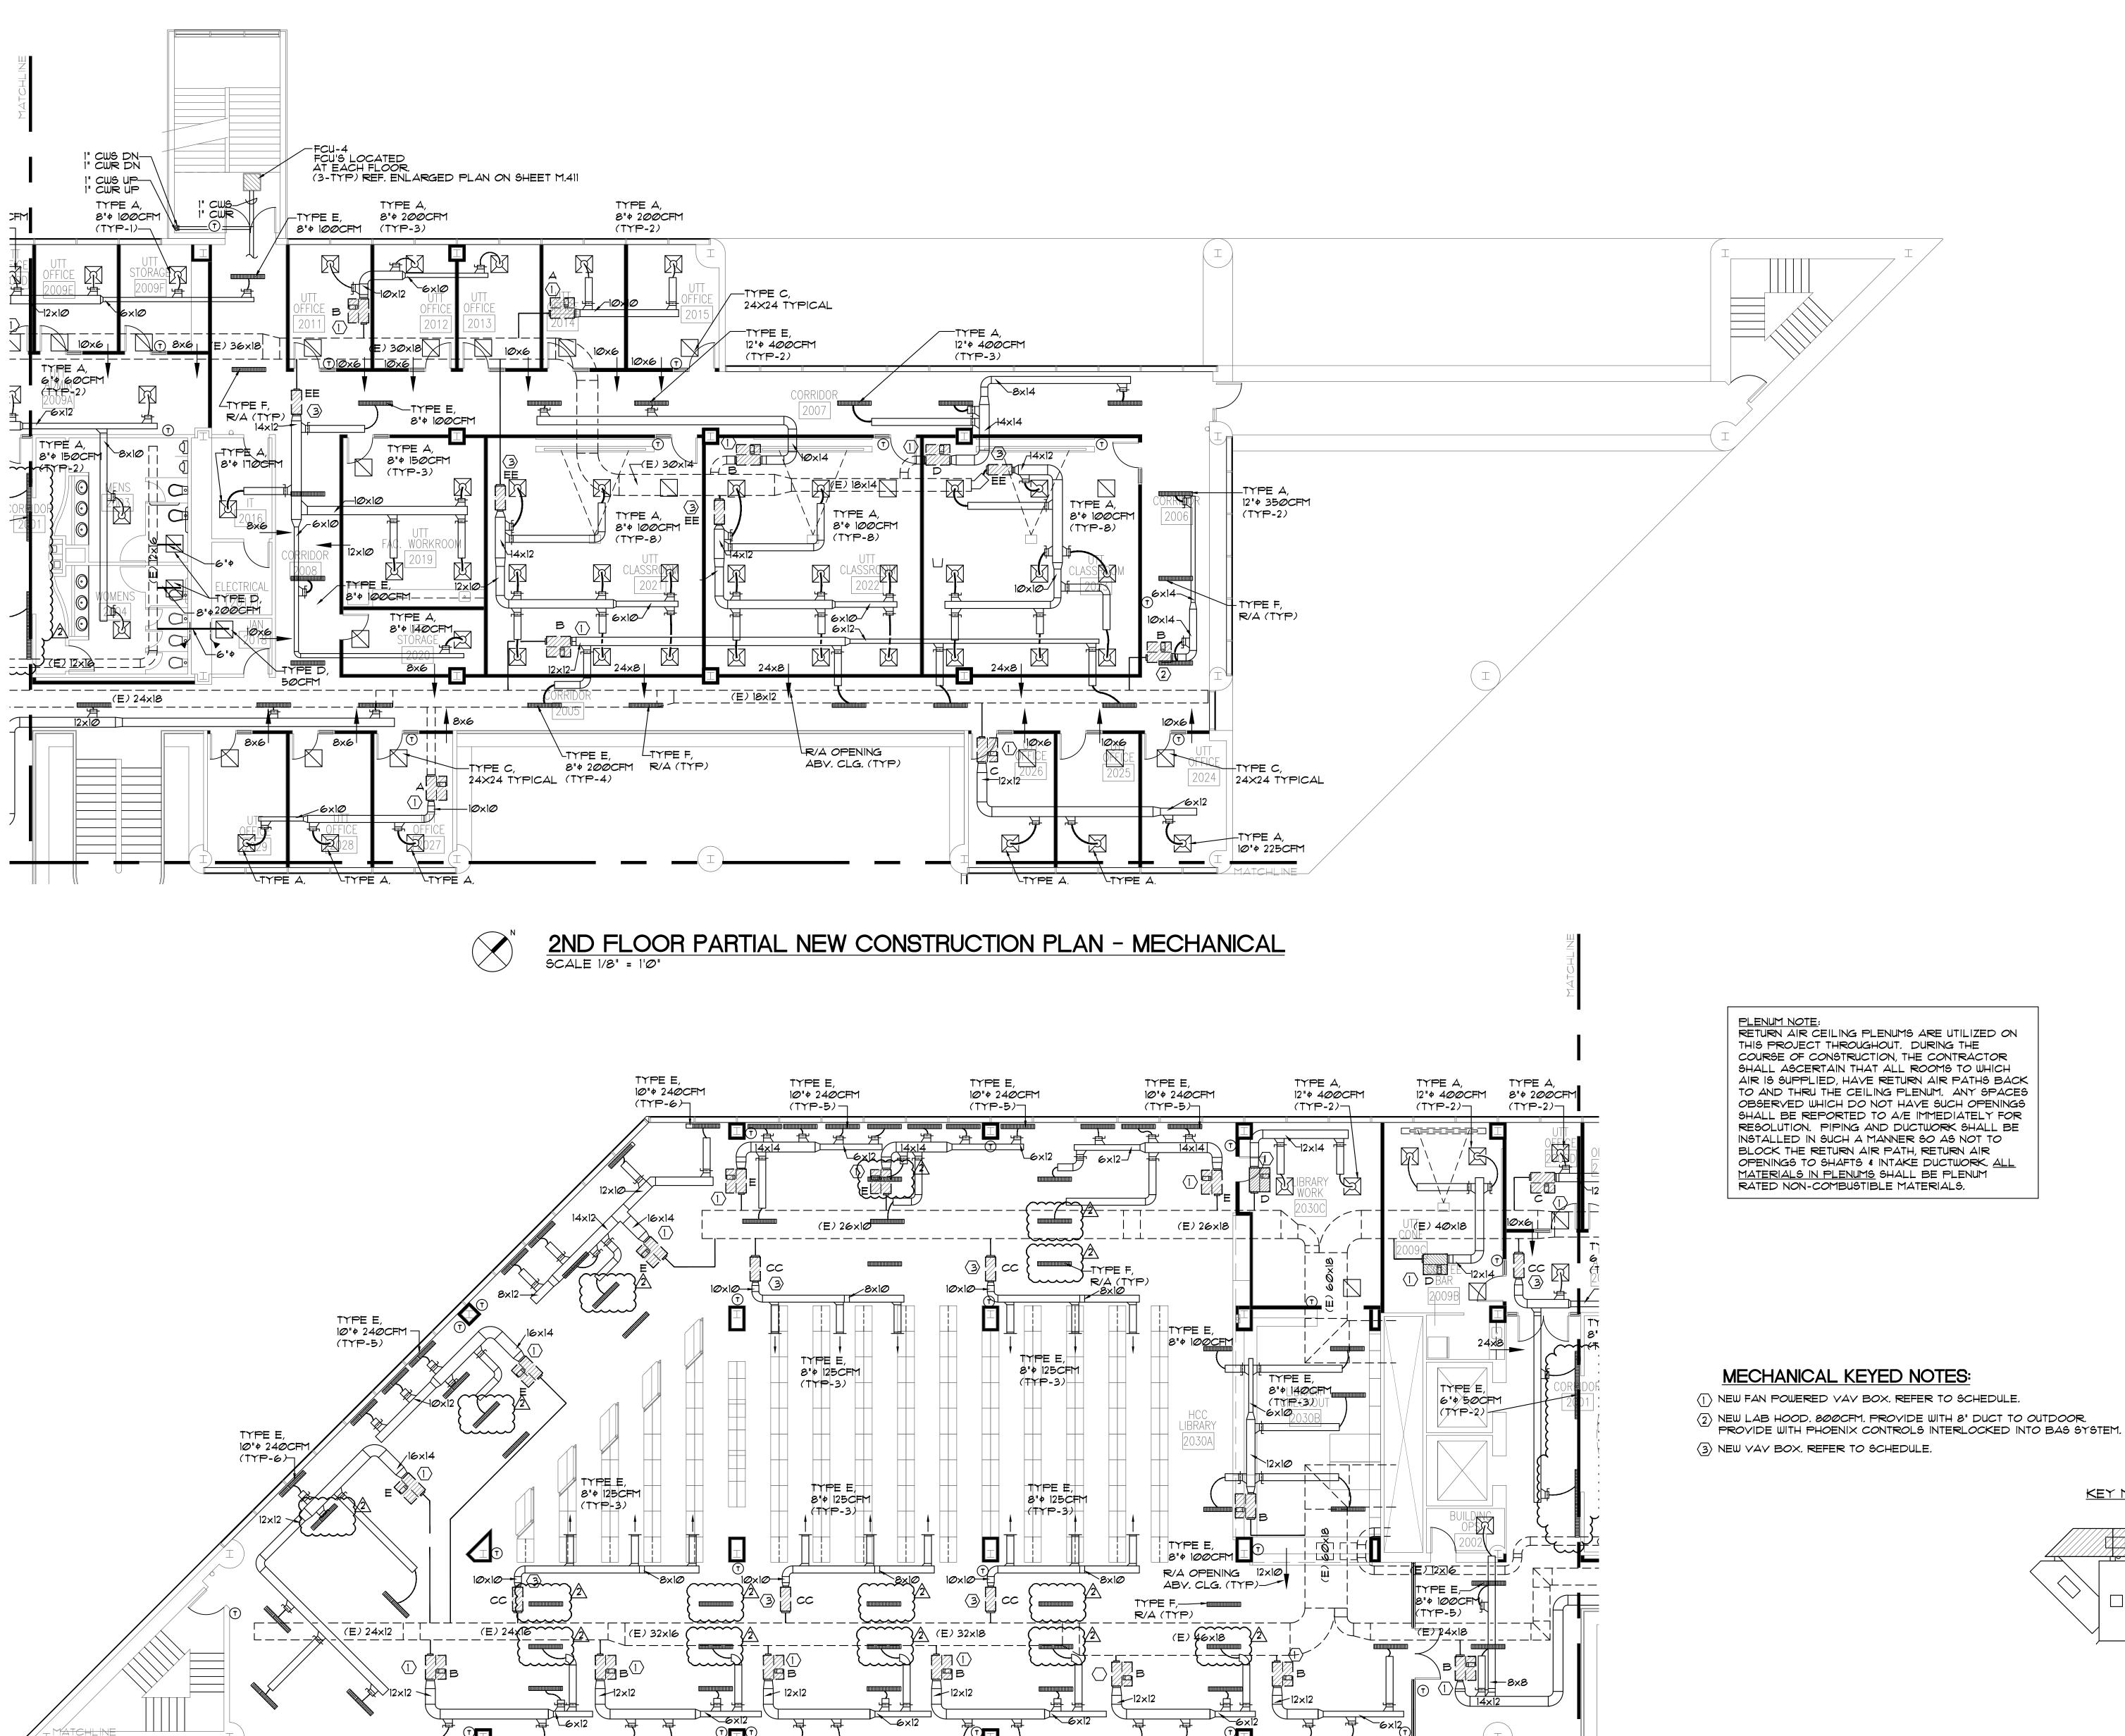

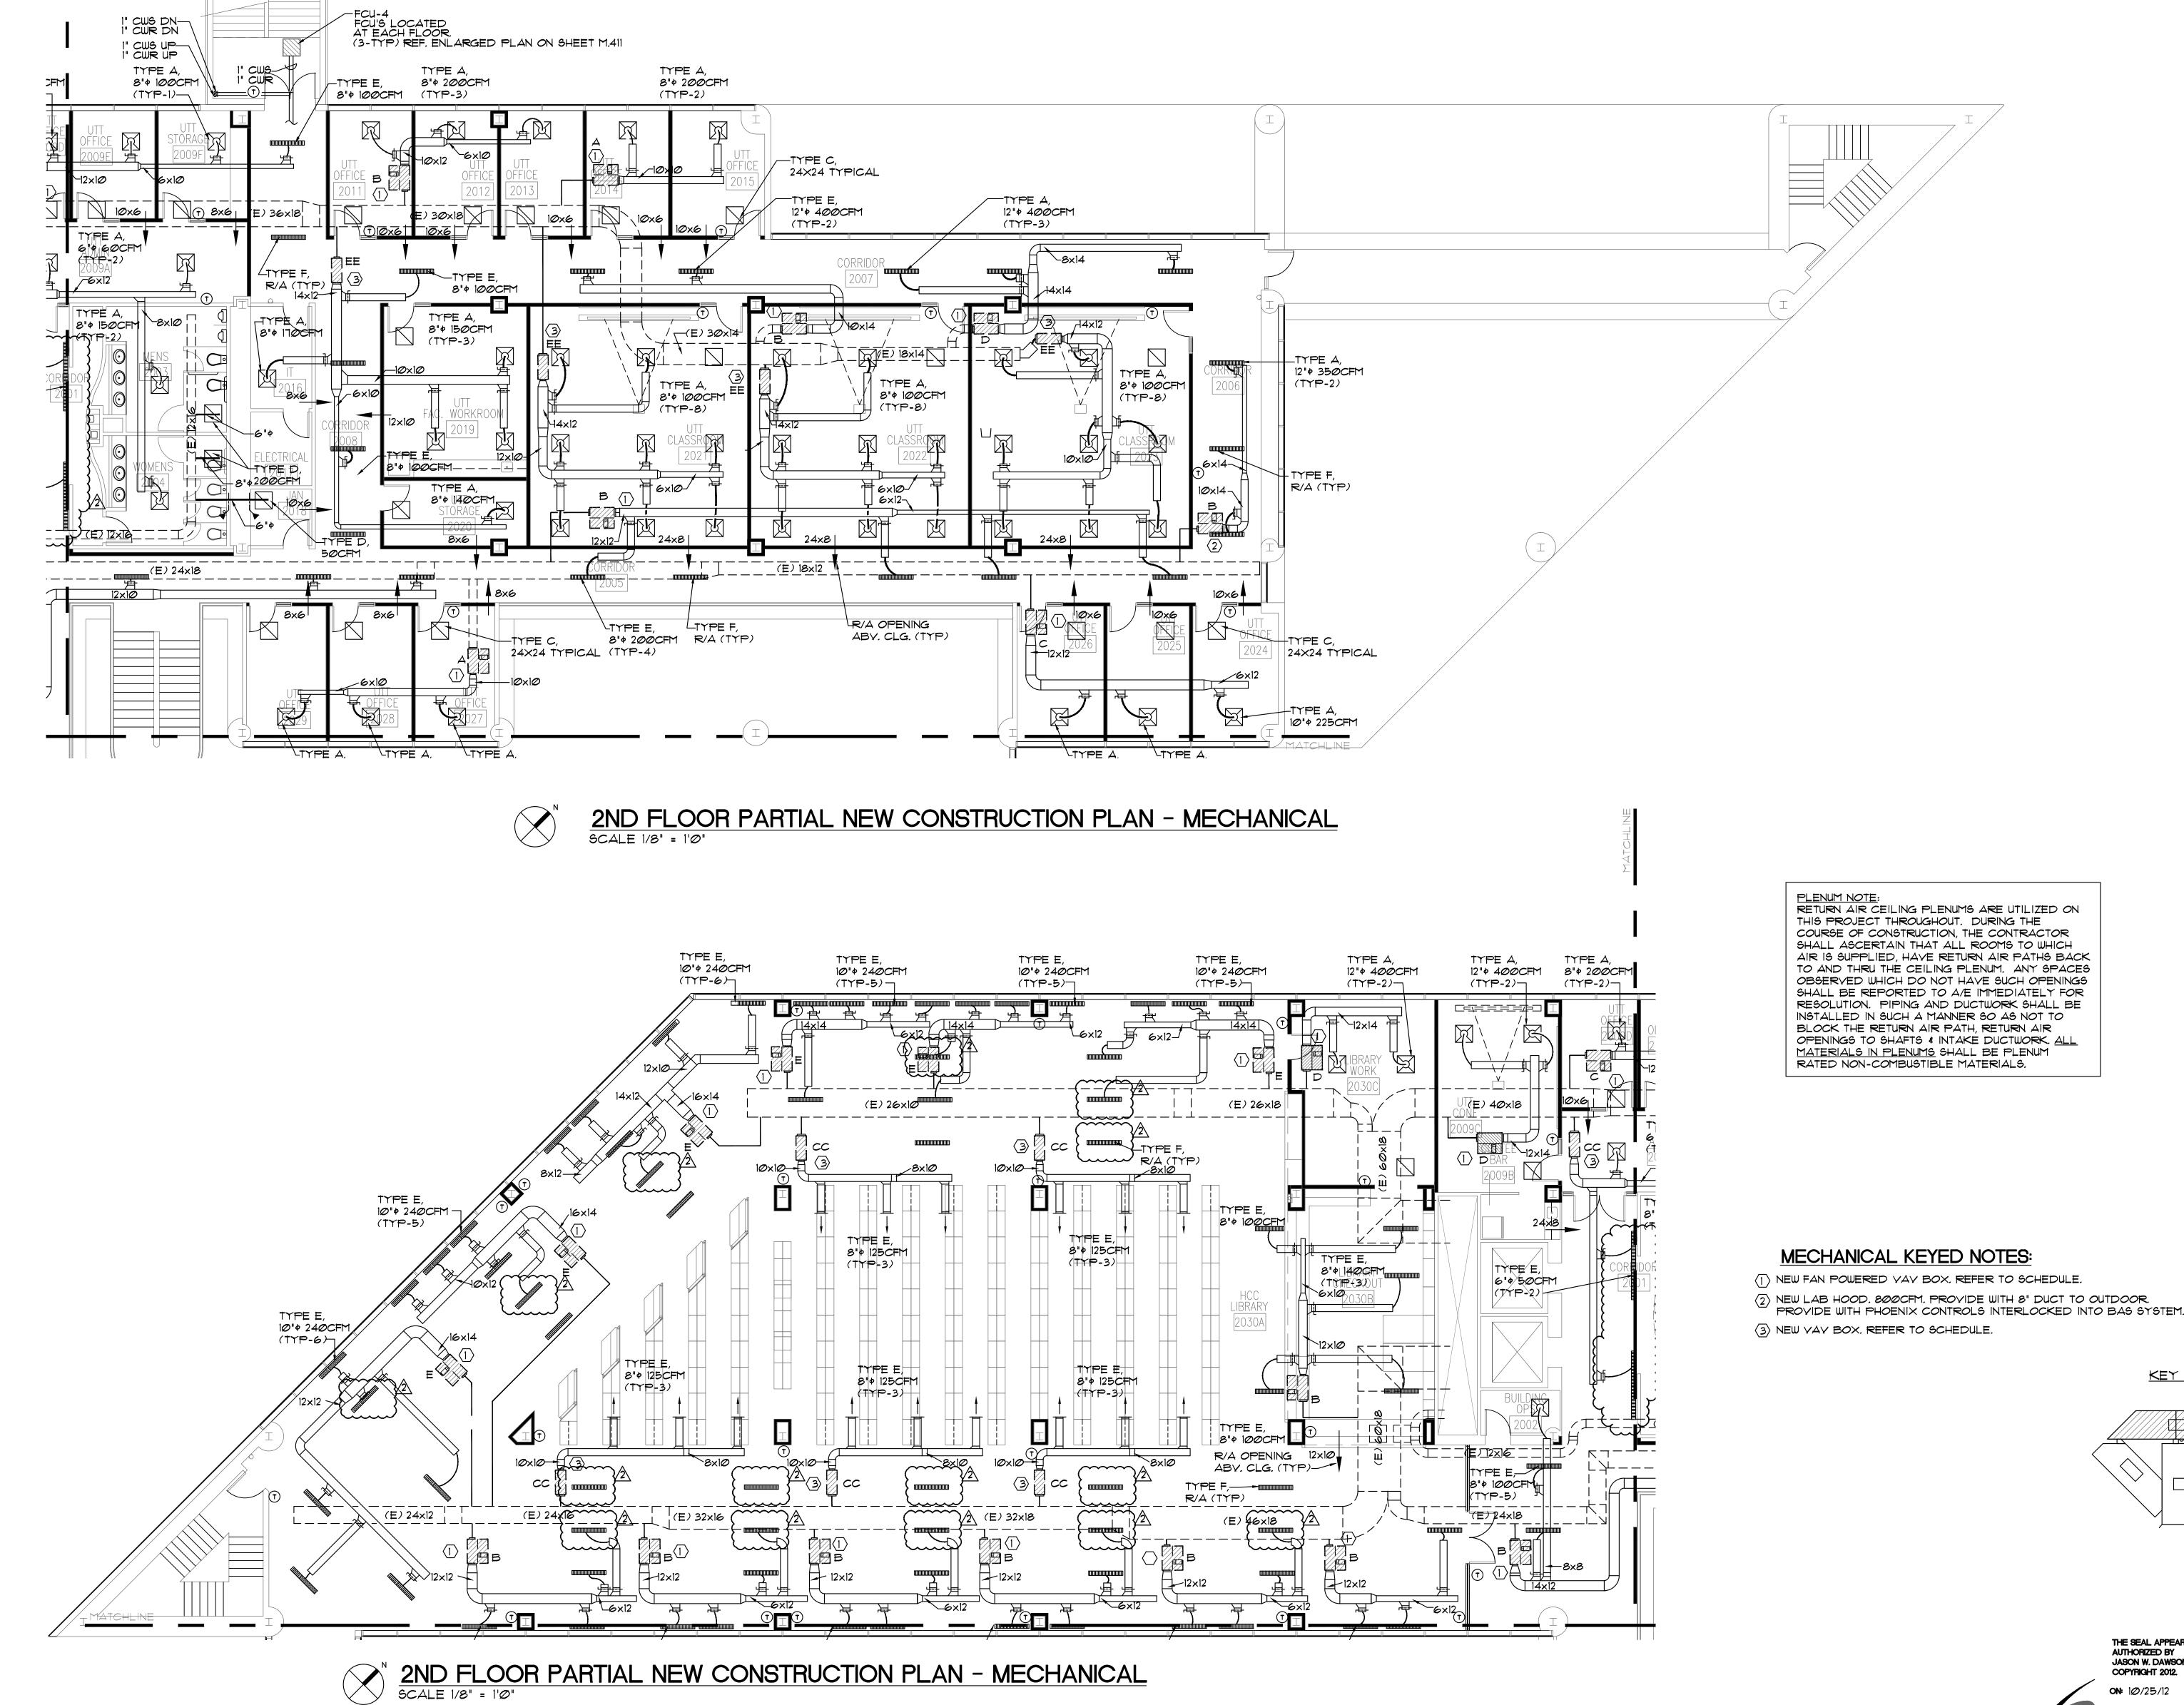

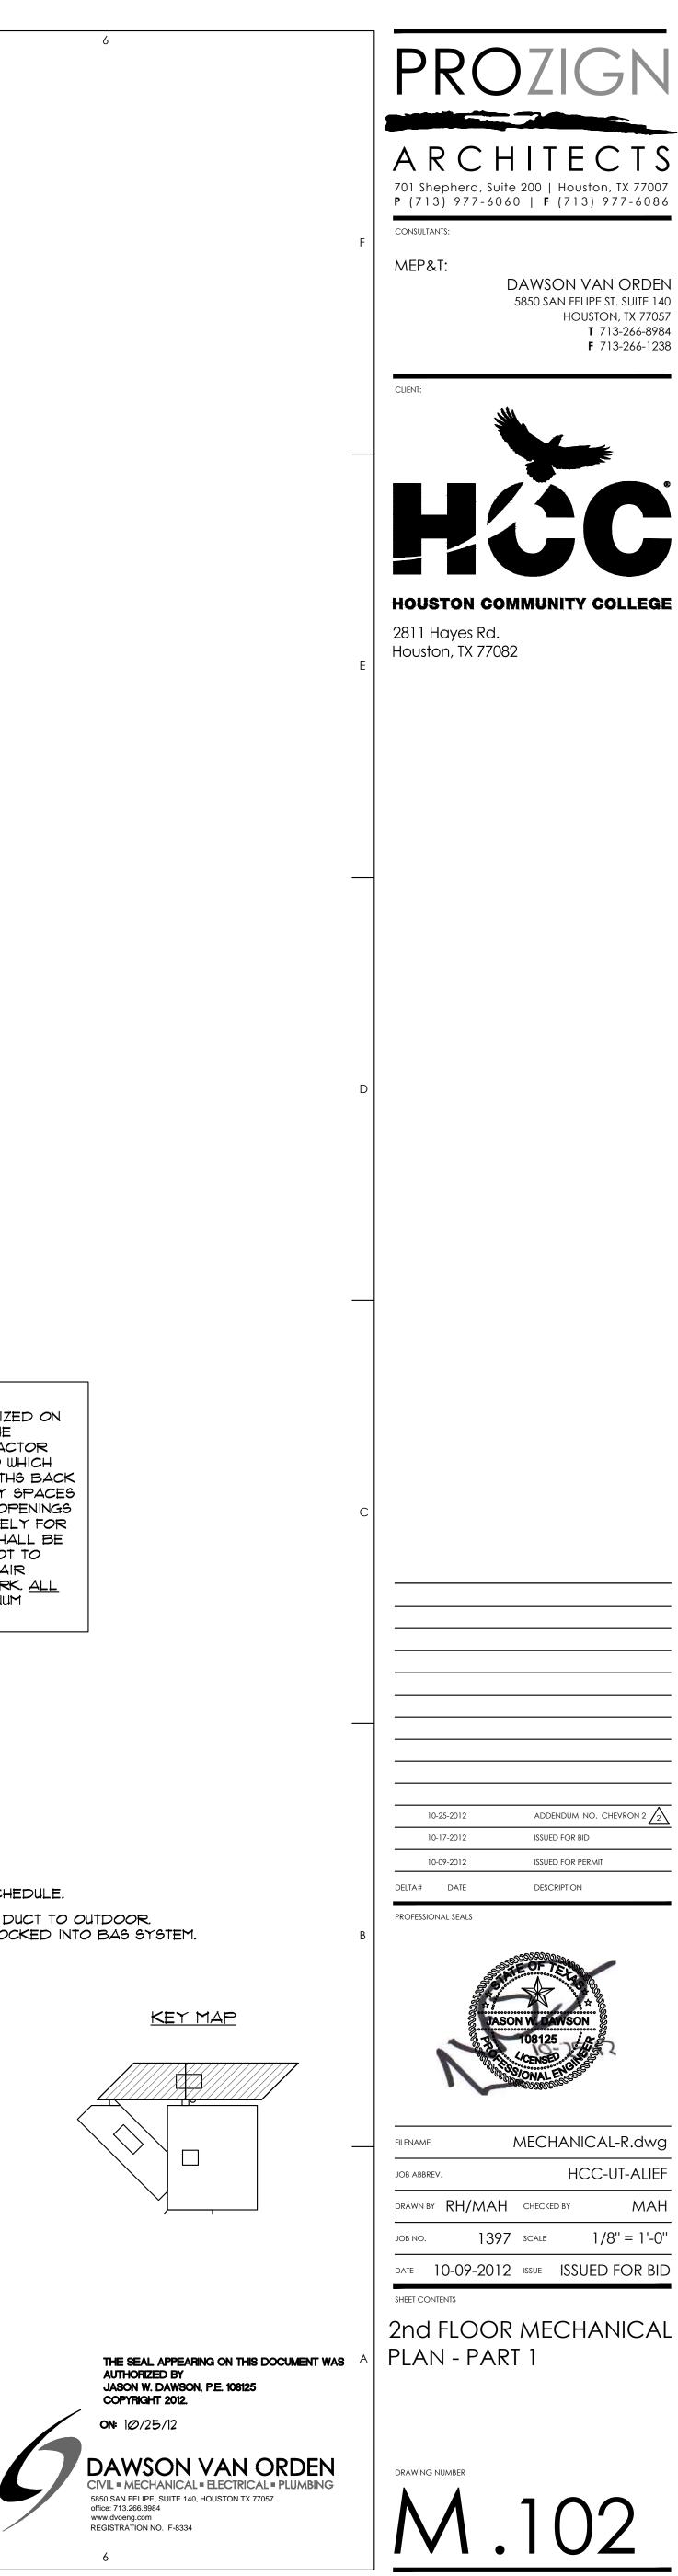

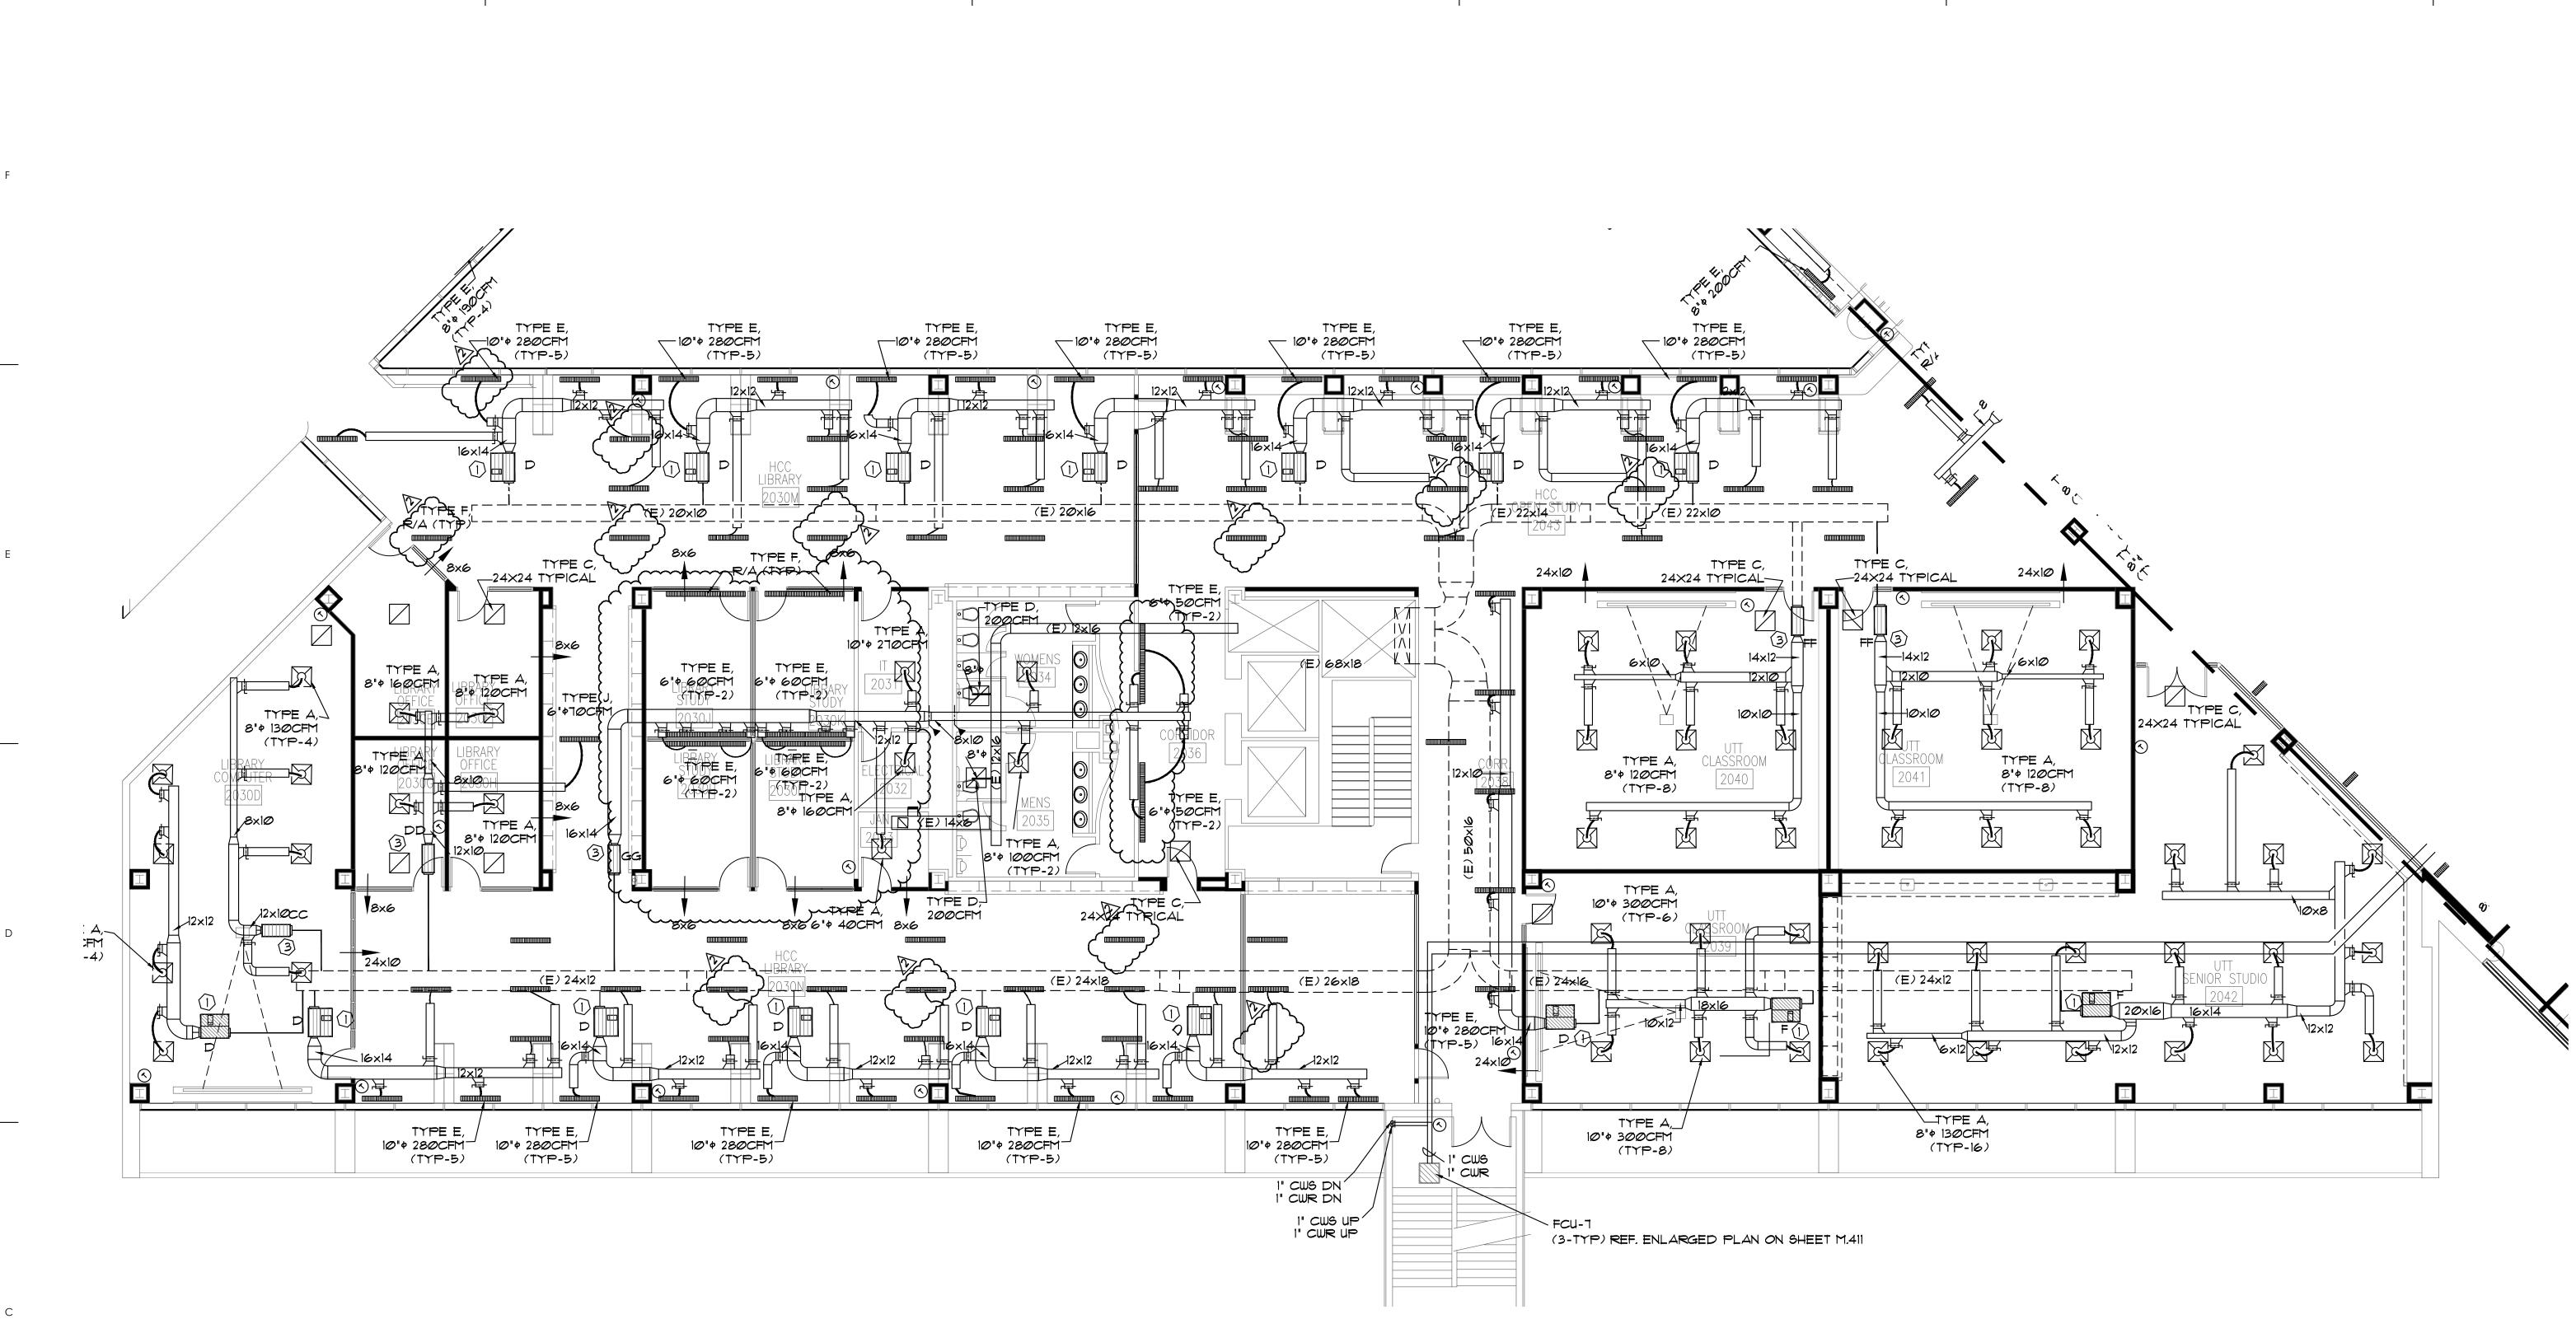

3











1

2

) 2ND FLOOR PARTIAL NEW CONSTRUCTION PLAN - MECHANICAL SCALE 1/8" = 1'0"

MECHANICAL KEYED NOTES:


 $\langle \overline{1} \rangle$ NEW FAN POWERED VAV BOX. REFER TO SCHEDULE.


NEW LAB HOOD. 800CFM. PROVIDE WITH 8" DUCT TO OUTDOOR. PROVIDE WITH PHOENIX CONTROLS INTERLOCKED INTO BAS SYSTEM.


4


 $\langle 3 \rangle$ NEW VAV BOX. REFER TO SCHEDULE.


<u>PLENUM NOTE:</u> RETURN AIR CEILING PLENUMS ARE UTILIZED ON THIS PROJECT THROUGHOUT. DURING THE COURSE OF CONSTRUCTION, THE CONTRACTOR SHALL ASCERTAIN THAT ALL ROOMS TO WHICH AIR IS SUPPLIED, HAVE RETURN AIR PATHS BACK TO AND THRU THE CEILING PLENUM. ANY SPACES OBSERVED WHICH DO NOT HAVE SUCH OPENINGS SHALL BE REPORTED TO A/E IMMEDIATELY FOR RESOLUTION. PIPING AND DUCTWORK SHALL BE INSTALLED IN SUCH A MANNER SO AS NOT TO BLOCK THE RETURN AIR PATH, RETURN AIR OPENINGS TO SHAFTS & INTAKE DUCTWORK. <u>All</u> MATERIALS IN PLENUMS SHALL BE PLENUM RATED NON-COMBUSTIBLE MATERIALS.

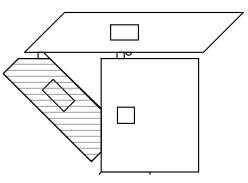

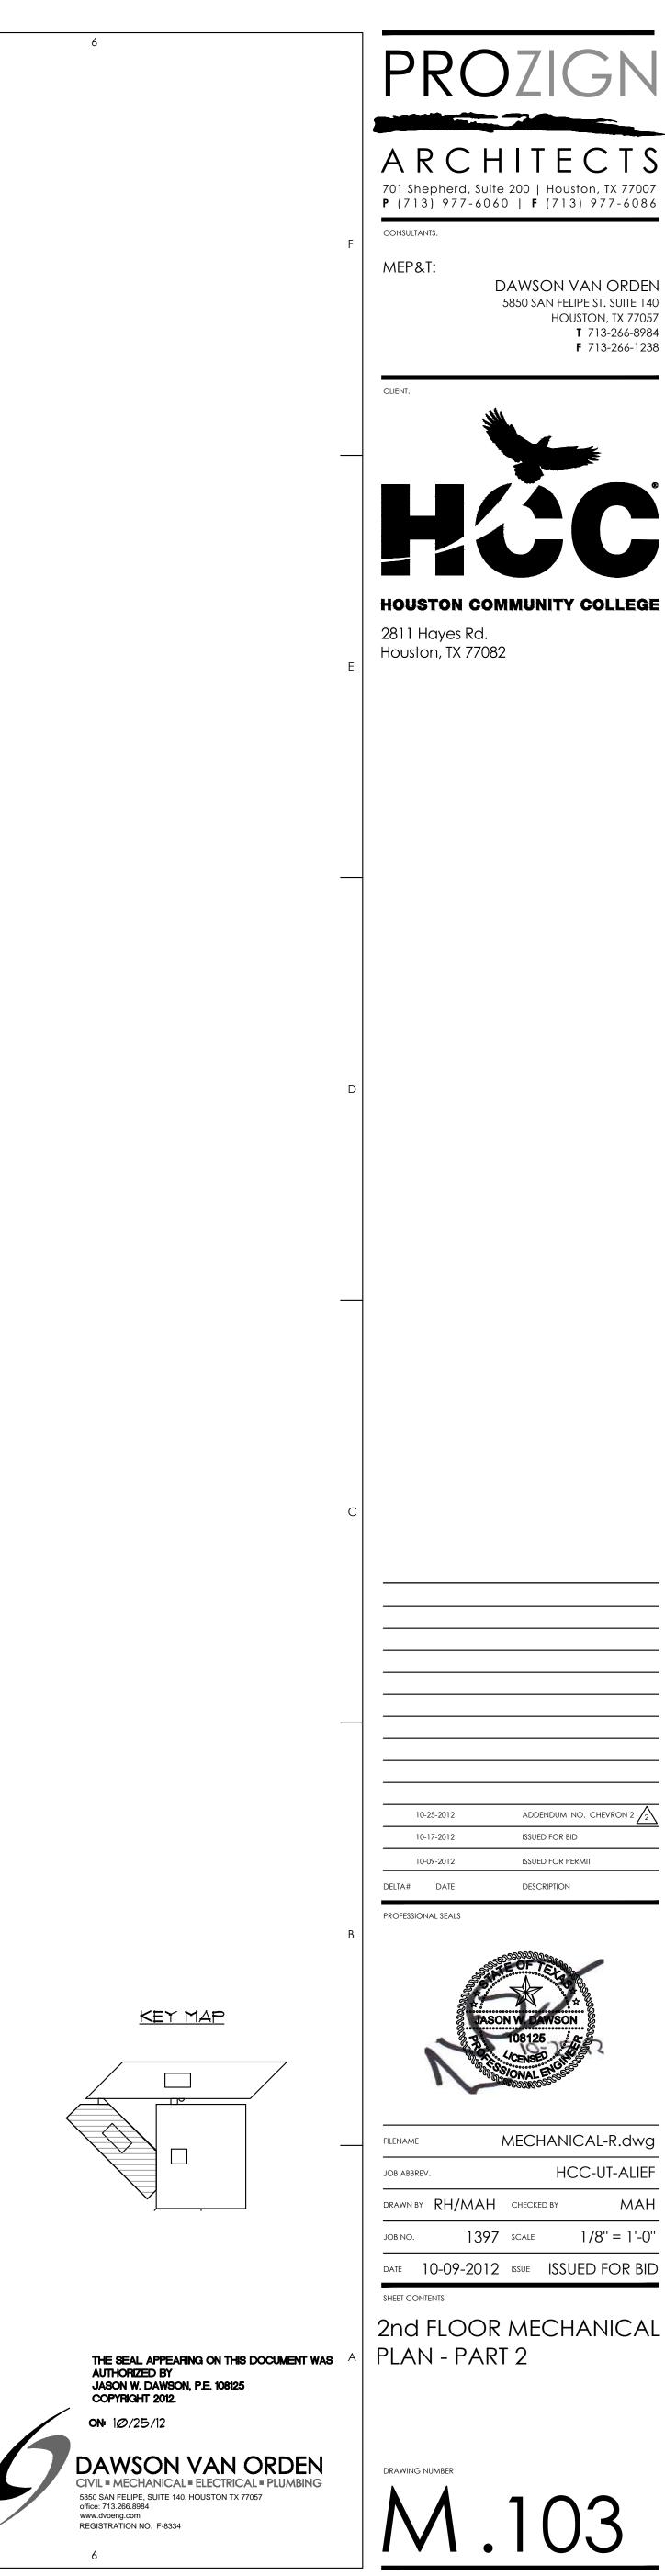


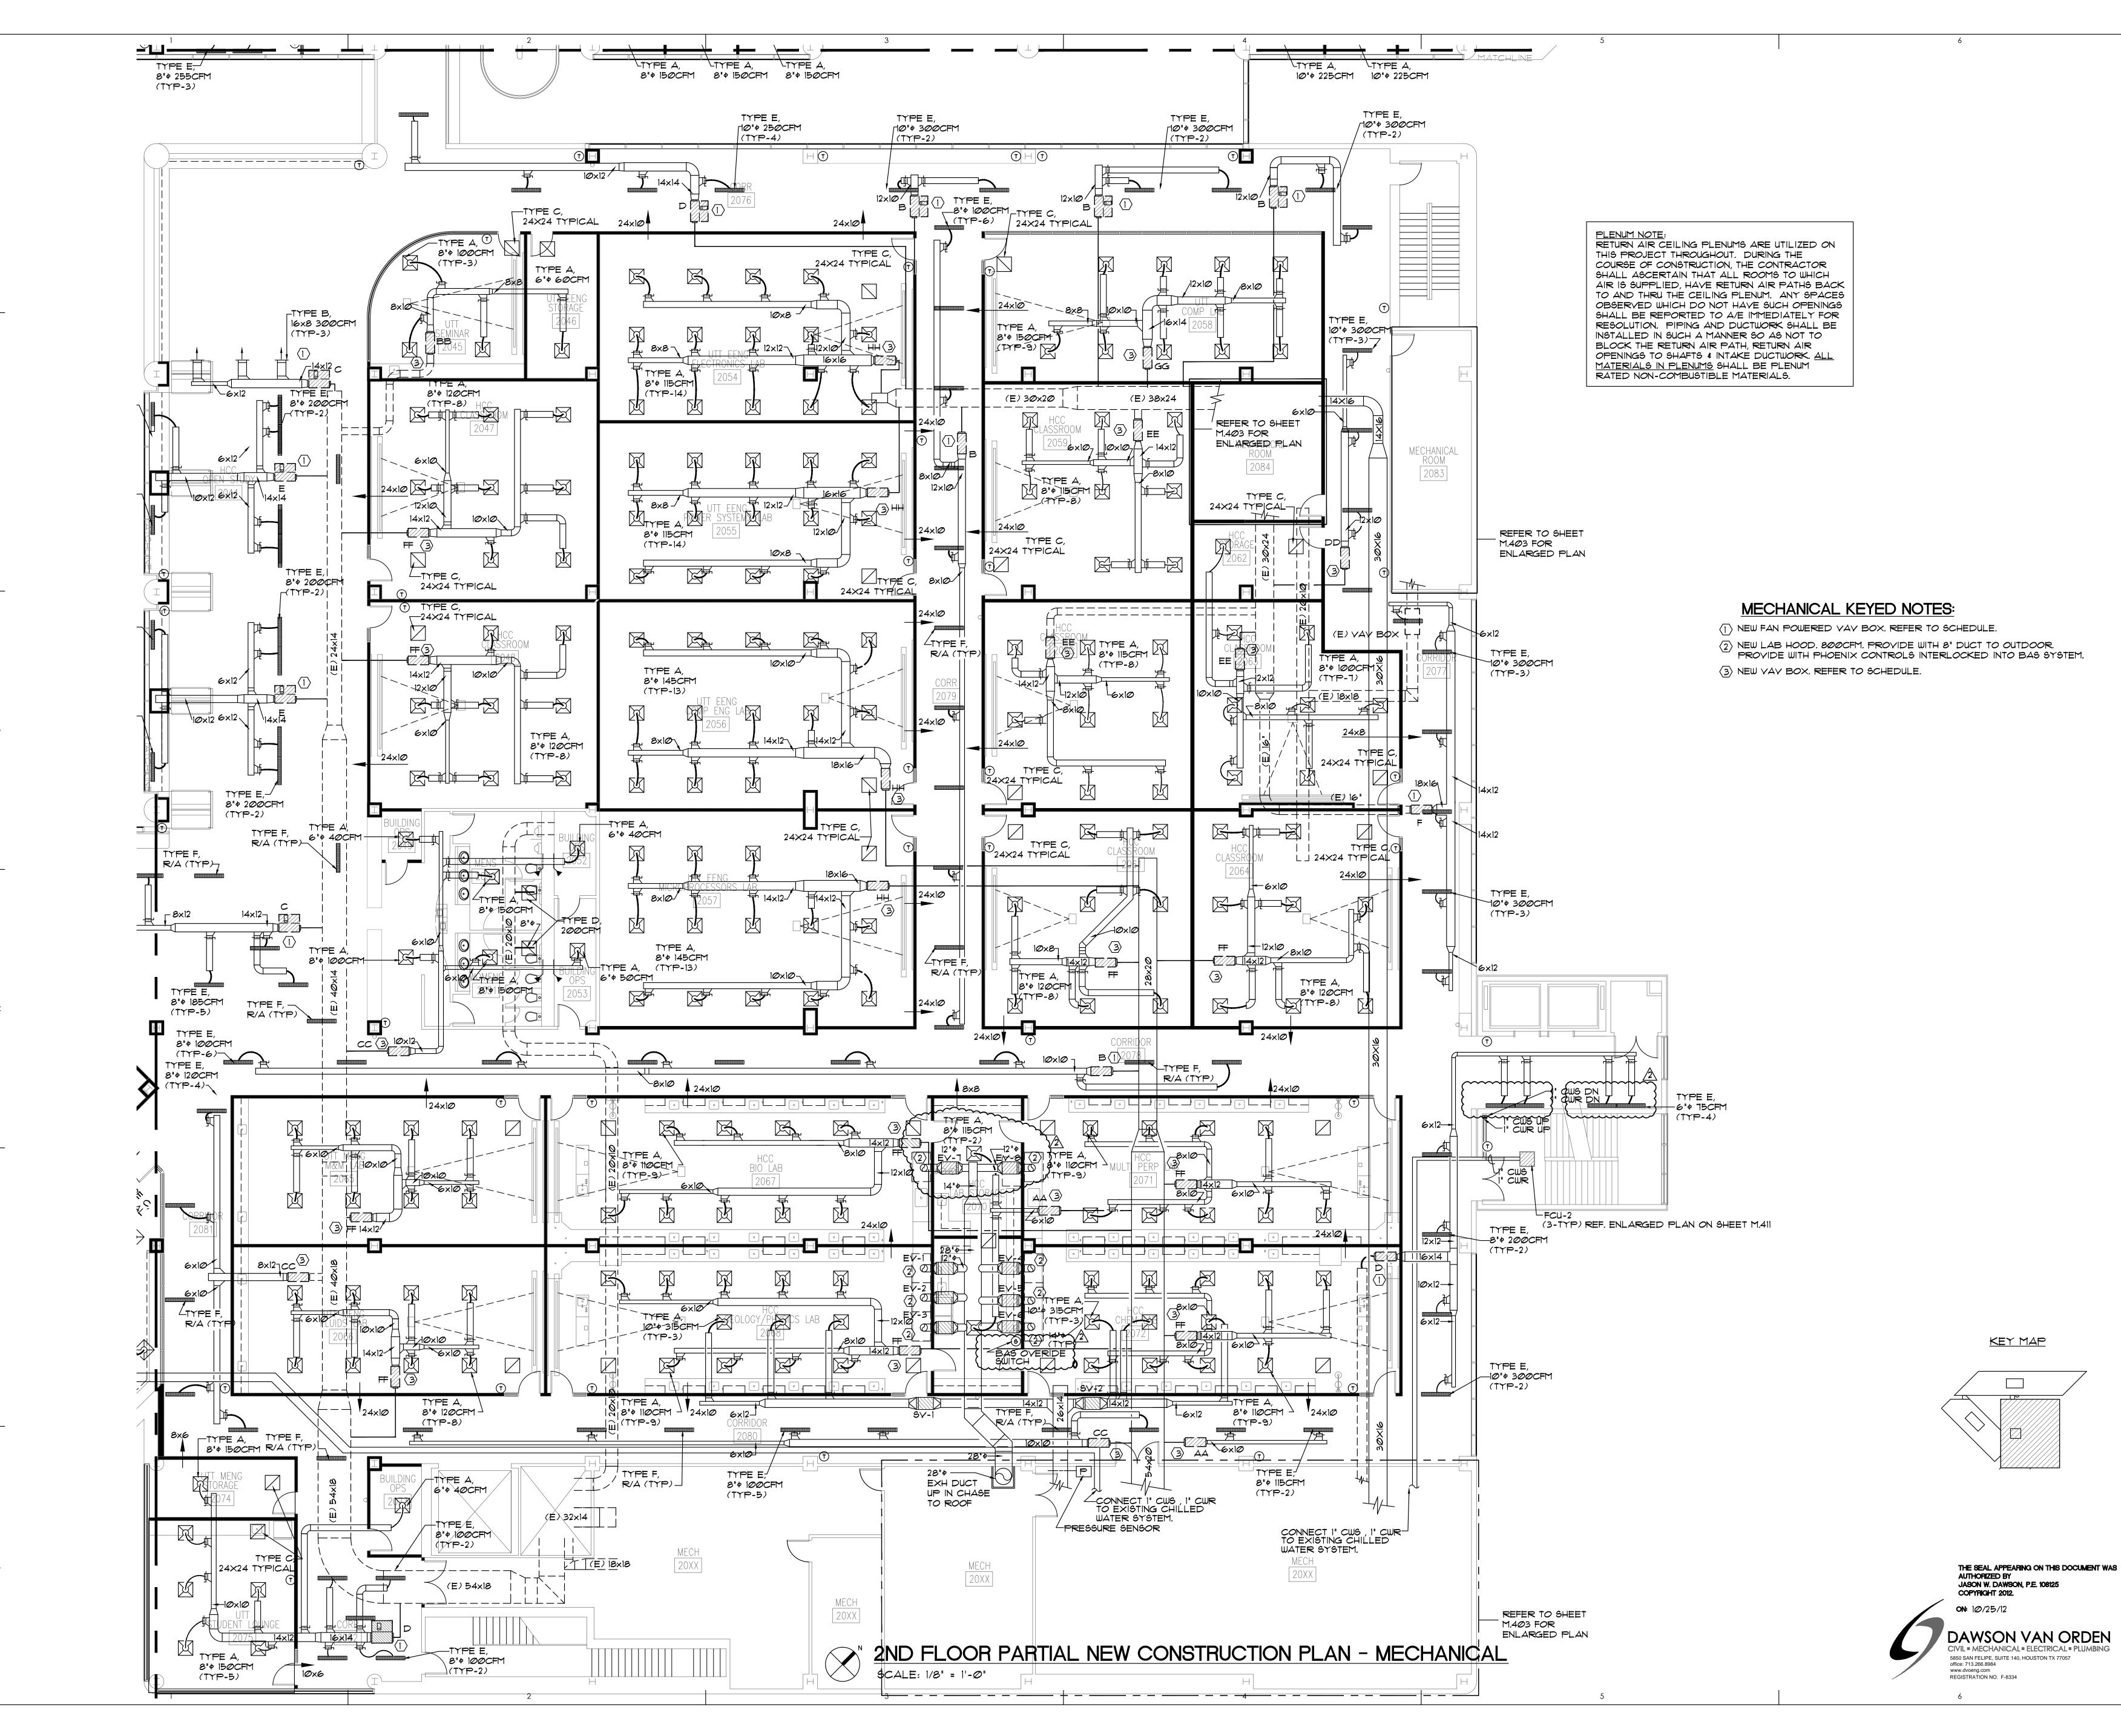

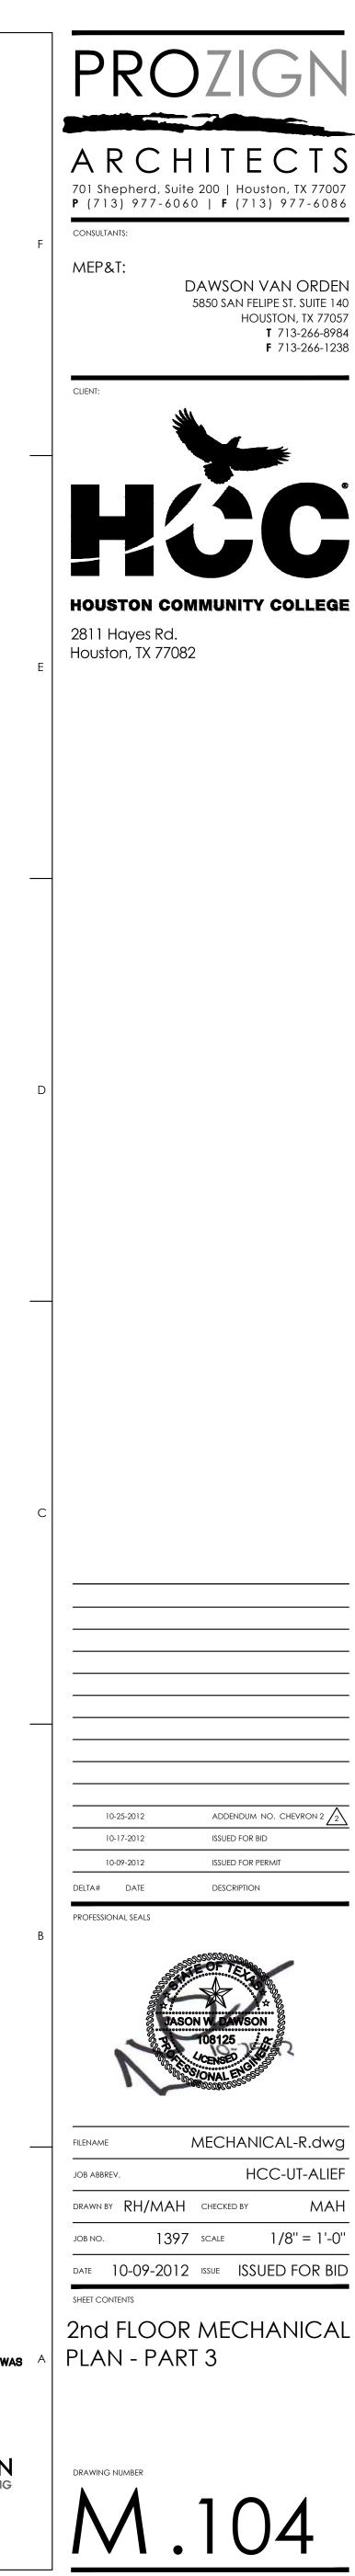

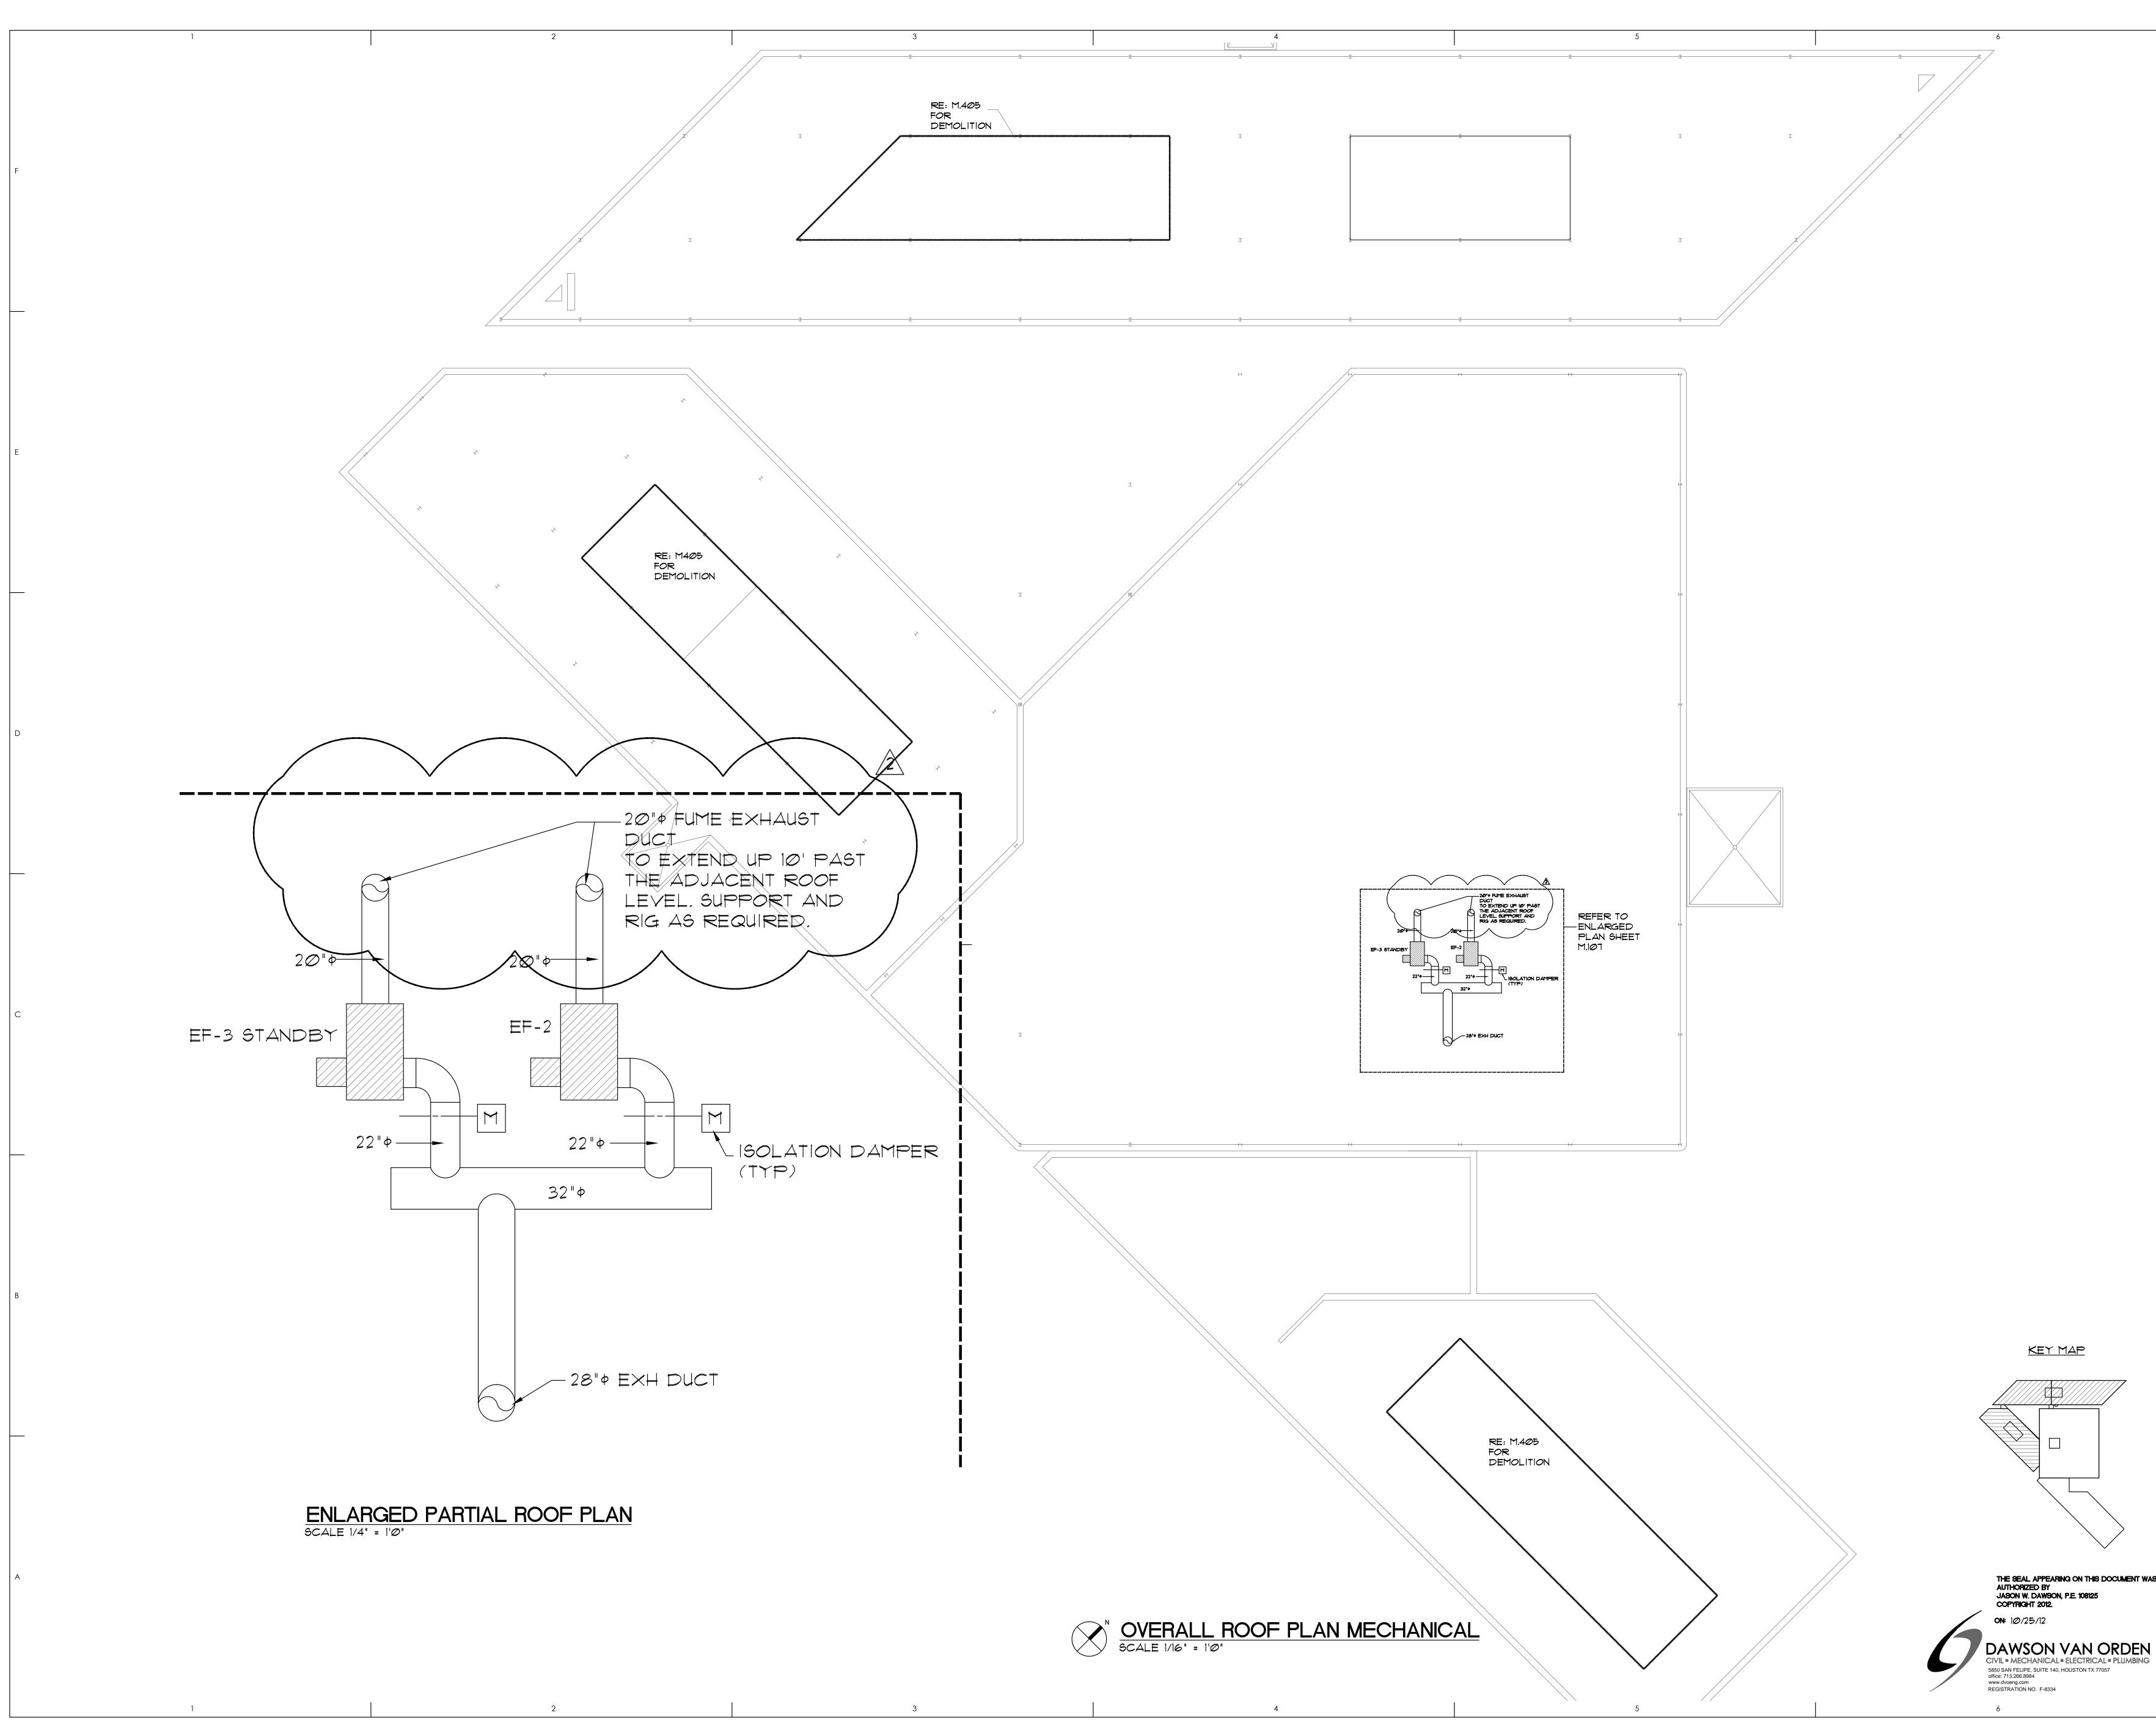

	PROZIGN
F	A R C H I T E C T S 701 Shepherd, Suite 200 Houston, TX 77007 P (713) 977-6060 F (713) 977-6086 CONSULTANTS:
Γ	MEP&T: DAWSON VAN ORDEN 5850 SAN FELIPE ST. SUITE 140 HOUSTON, TX 77057 T 713-266-8984 F 713-266-1238
	HOUSTON COMMUNITY COLLEGE
E	2811 Hayes Rd. Houston, TX 77082
D	
С	
	10-25-2012 ADDENDUM NO. CHEVRON 2 2 10-17-2012 ISSUED FOR BID
В	10-09-2012 ISSUED FOR PERMIT DELTA# DATE DESCRIPTION PROFESSIONAL SEALS
	JASON W DAWSON TO8125 CENSED SS/ONAL ENGINE
	FILENAME MECHANICAL-R.dwg JOB ABBREV. DRAWN BY RH/MAH CHECKED BY MAH
	JOB NO. 1397 SCALE 1/16" = 1'-0" DATE 10-09-2012 ISSUE ISSUED FOR BID SHEET CONTENTS ROOF MECHANICAL PLAN
was A	DRAWING NUMBER
G	M.107

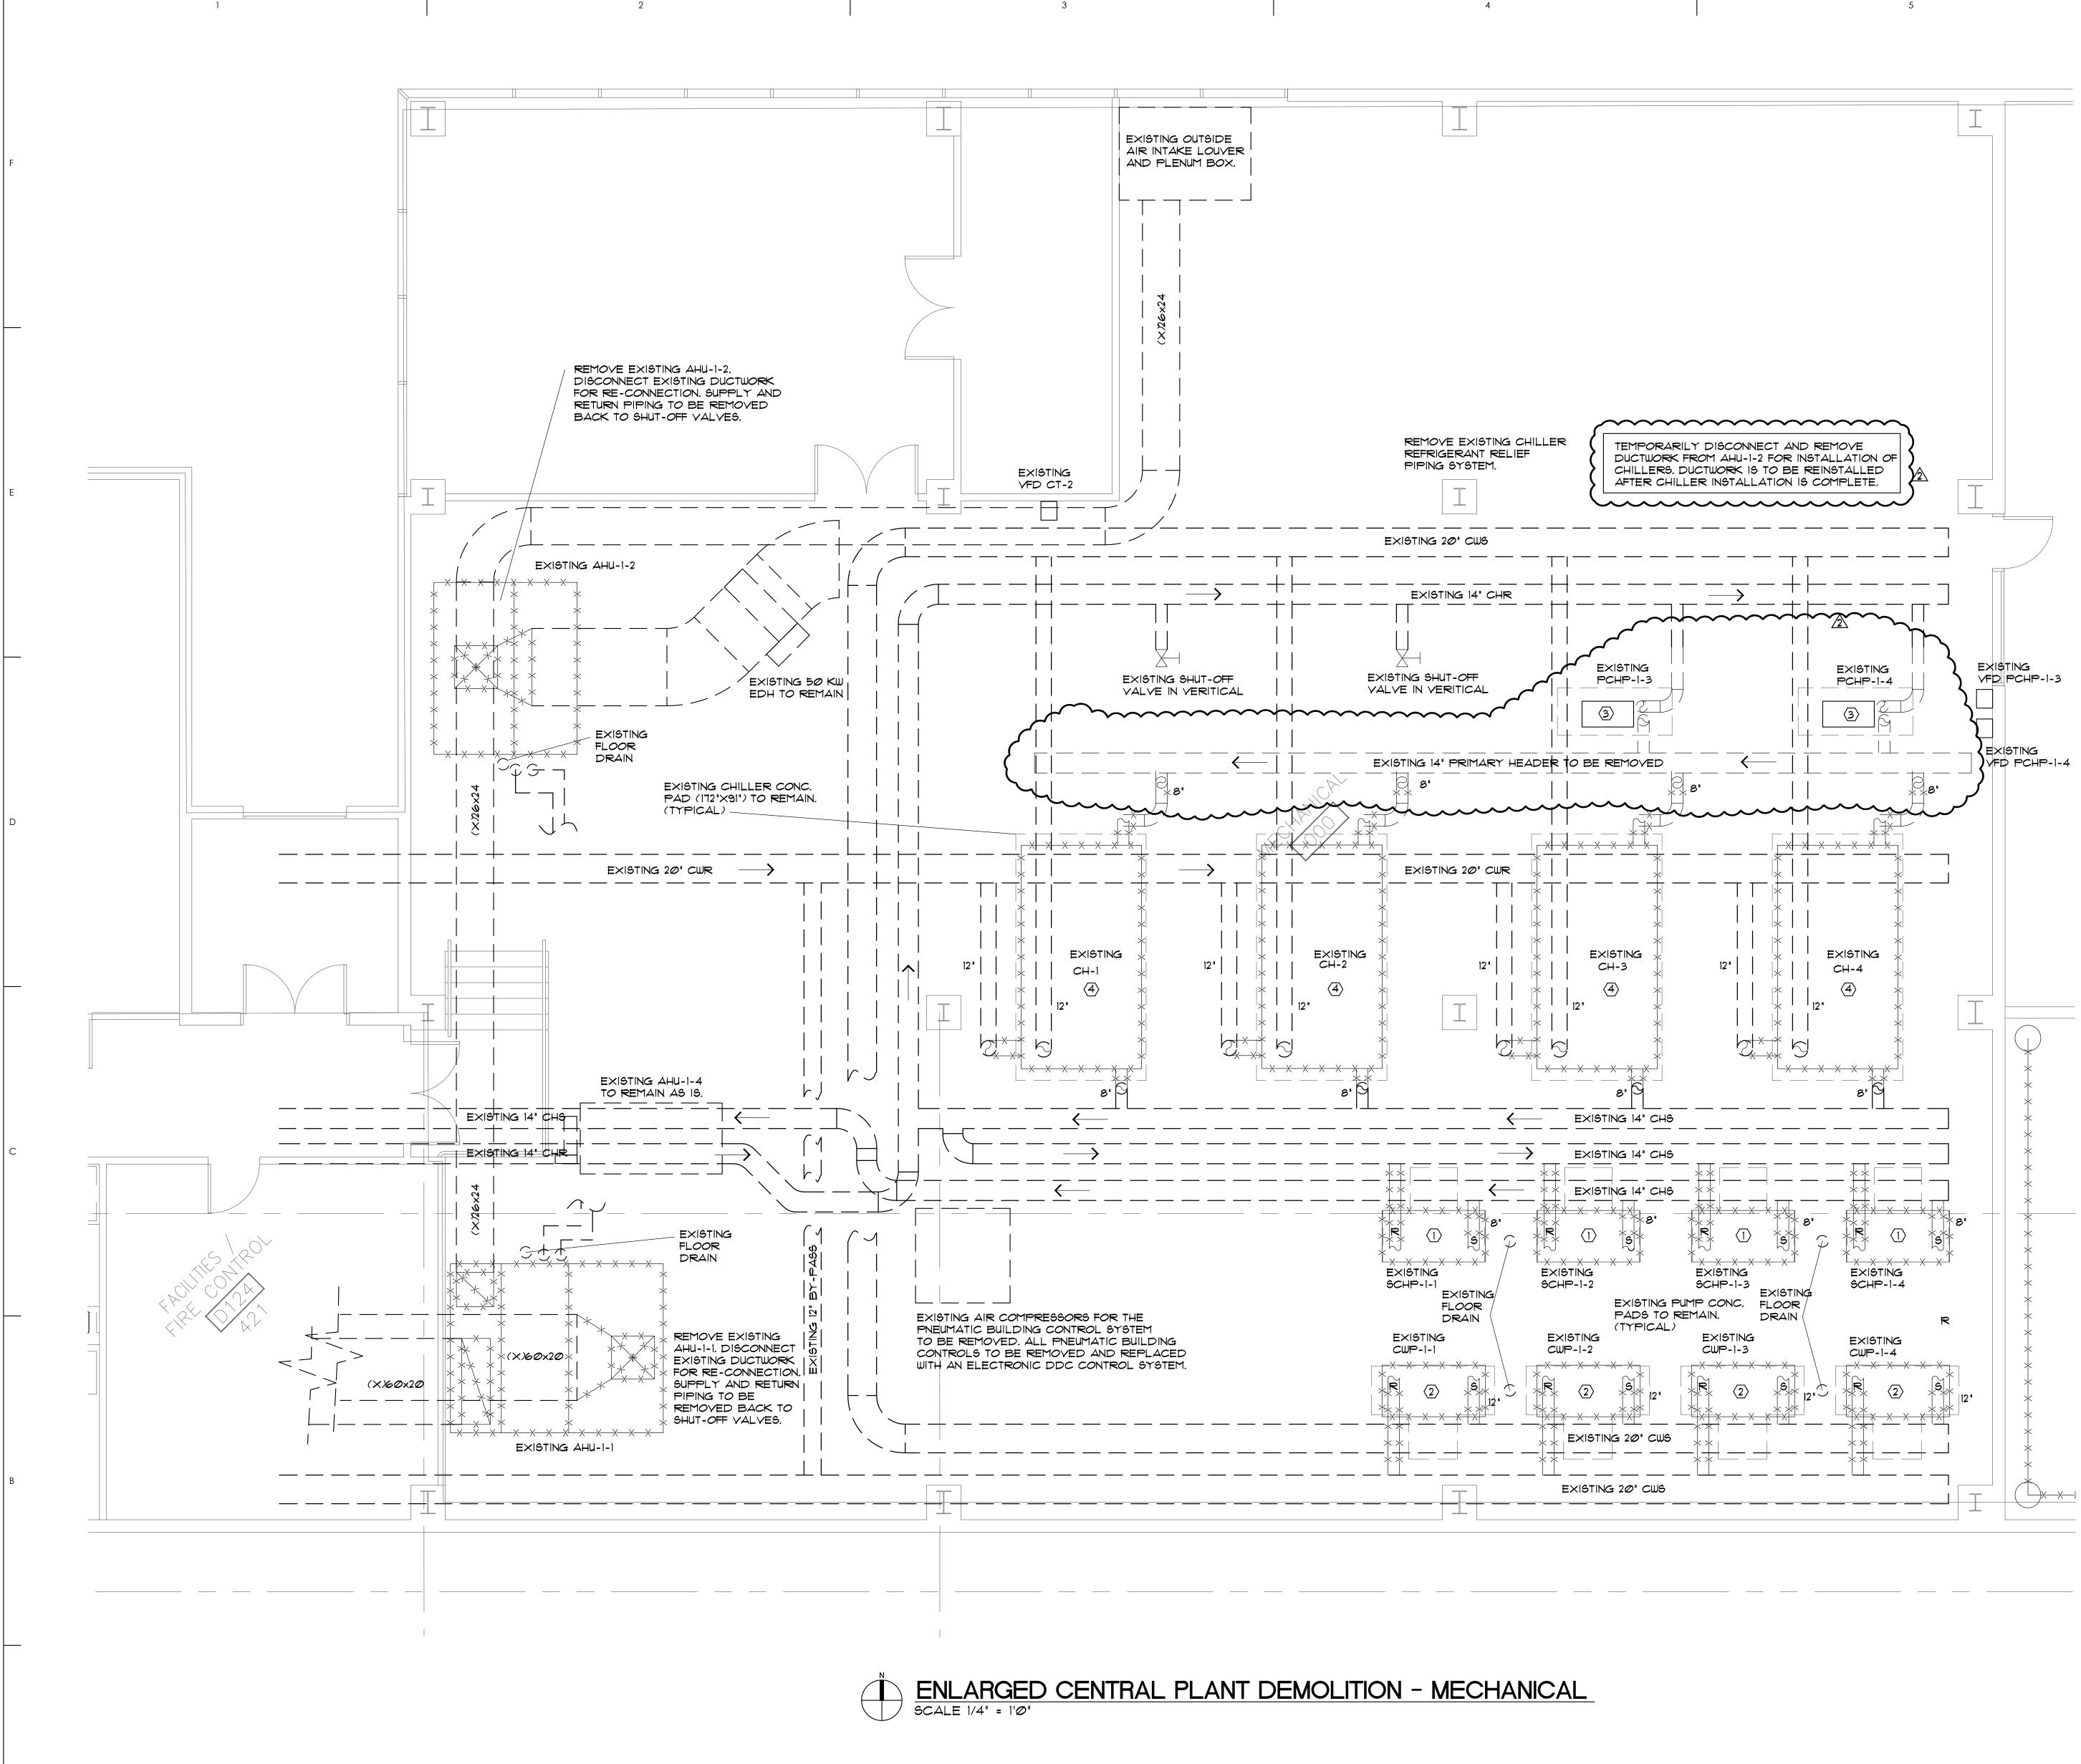


MECHANICAL DEMOLITION KEYED NOTES:

- (1) REMOVE EXISTING SECONDARY CHILLED WATER PUMP AND DISCONNECT/REMOVE 8' CHILLED WATER PIPING BACK TO SHUT-OFF VALVES AS REQUIRED FOR REMOVAL AND RE-INSTALLATION OF NEW PUMP, REMOVE ALL EXISTING PUMP CONTROL VALVING. PUMP REPLACEMENT TO BE PHASED.
- $\langle 2 \rangle$ REMOVE EXISTING CONDENSER WATER PUMP AND DISCONNECT/REMOVE CONDENSER 12" WATER PIPING BACK TO SHUT-OFF VALVES AS REQUIRED FOR REMOVAL AND RE-INSTALLATION OF NEW PUMP. REMOVE ALL EXISTING PUMP CONTROL VALVING. PUMP REPLACEMENT TO BE PHASED.
- $\langle 3 \rangle$ Existing 15 HP primary chilled water pump with vFD to BE TEMPORARILY DISCONNECTED AND REMOVED FOR NEW CHILLER INSTALLATION. CONTRACTOR TO FIELD VERIFY REMOVAL REQUIREMENTS OF PUMPS AND PUMP PADS. PUMPS AND PUMP PADS TO BE RE-INSTALLED AFTER ASSOCIATED CHILLER IS INSTALLED.
- $\langle \overline{4} \rangle$ REMOVE EXISTING WATER COOLED CHILLER. DISCONNECT/REMOVE ALL CHILLED WATER AND CONDENSER WATER PIPING BACK TO SHUT-OFF VALVES AS REQUIRED FOR REMOVAL AND RE-INSTALLATION OF NEW CHILLER. REMOVE ALL EXISTING CHILLER CONTROL VALVING. CHILLER REPLACEMENT TO BE PHASED.


MECHANICAL SYMBOLS

АНЦ	AIR HANDLING UNIT
ACC	AIR COOLED CHILLER
ACCU	AIR COOLED CONDENSING UNIT
CD	CONDENGATE DRAIN
DB	DRY BULB
EF	EXHAUST FAN
FCU	FAN COIL UNIT
FD	FIRE DAMPER
F	FAHRENHEIT DEGREE
FLEX	FLEXIBLE CONNECTION
GPM	GALLONS PER MINUTE
HWS	HEATING WATER SUPPLY
HWR	HEATING WATER RETURN
HP	HORSE POWER
MVD	MANUAL VOLUME DAMPER
MUU	MAKE UP AHU
0A	OUTSIDE AIR
OBD	OPPOSED BLADE DAMPER
RA	RETURN AIR
RH	RELATIVE HUMIDITY
RTU	ROOFTOP A/C UNIT
SA	SUPPLY AIR
Sm	SMOKE DETECTOR
SP	STATIC PRESSURE
SPEC	SPECIFICATION
TYP	TYPICAL
WB	WET BULB

<u>Key Map</u>

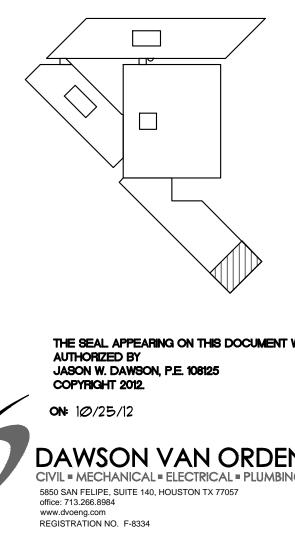

	PROZIGN
F	A R C H I T E C T S 701 Shepherd, Suite 200 Houston, TX 77007 P (713) 977-6060 F (713) 977-6086 CONSULTANTS: MEP&T: DAWSON VAN ORDEN
)	5850 SAN FELIPE ST. SUITE 140 HOUSTON, TX 77057 T 713-266-8984 F 713-266-1238
)))	
	HOUSTON COMMUNITY COLLEGE 2811 Hayes Rd.
E	Houston, TX 77082
_	
D	
C	
	10-25-2012 ADDENDUM NO. CHEVRON 2 2
В	10-17-2012 ISSUED FOR BID 10-09-2012 ISSUED FOR PERMIT DELTA# DATE PROFESSIONAL SEALS
	DASON VL DAWSON TO8125
	FILENAME MECHANICAL DEMO.dwg JOB ABBREV. DRAWN BY WD CHECKED BY JWD
	JOB NO. 1397 SCALE 1/4" = 1'-0" DATE 10-09-2012 ISSUE ISSUED FOR BID SHEET CONTENTS SHEET CONTENTS SHEET CONTENTS
was a	ENLARGED PLANS
N	DRAWING NUMBER

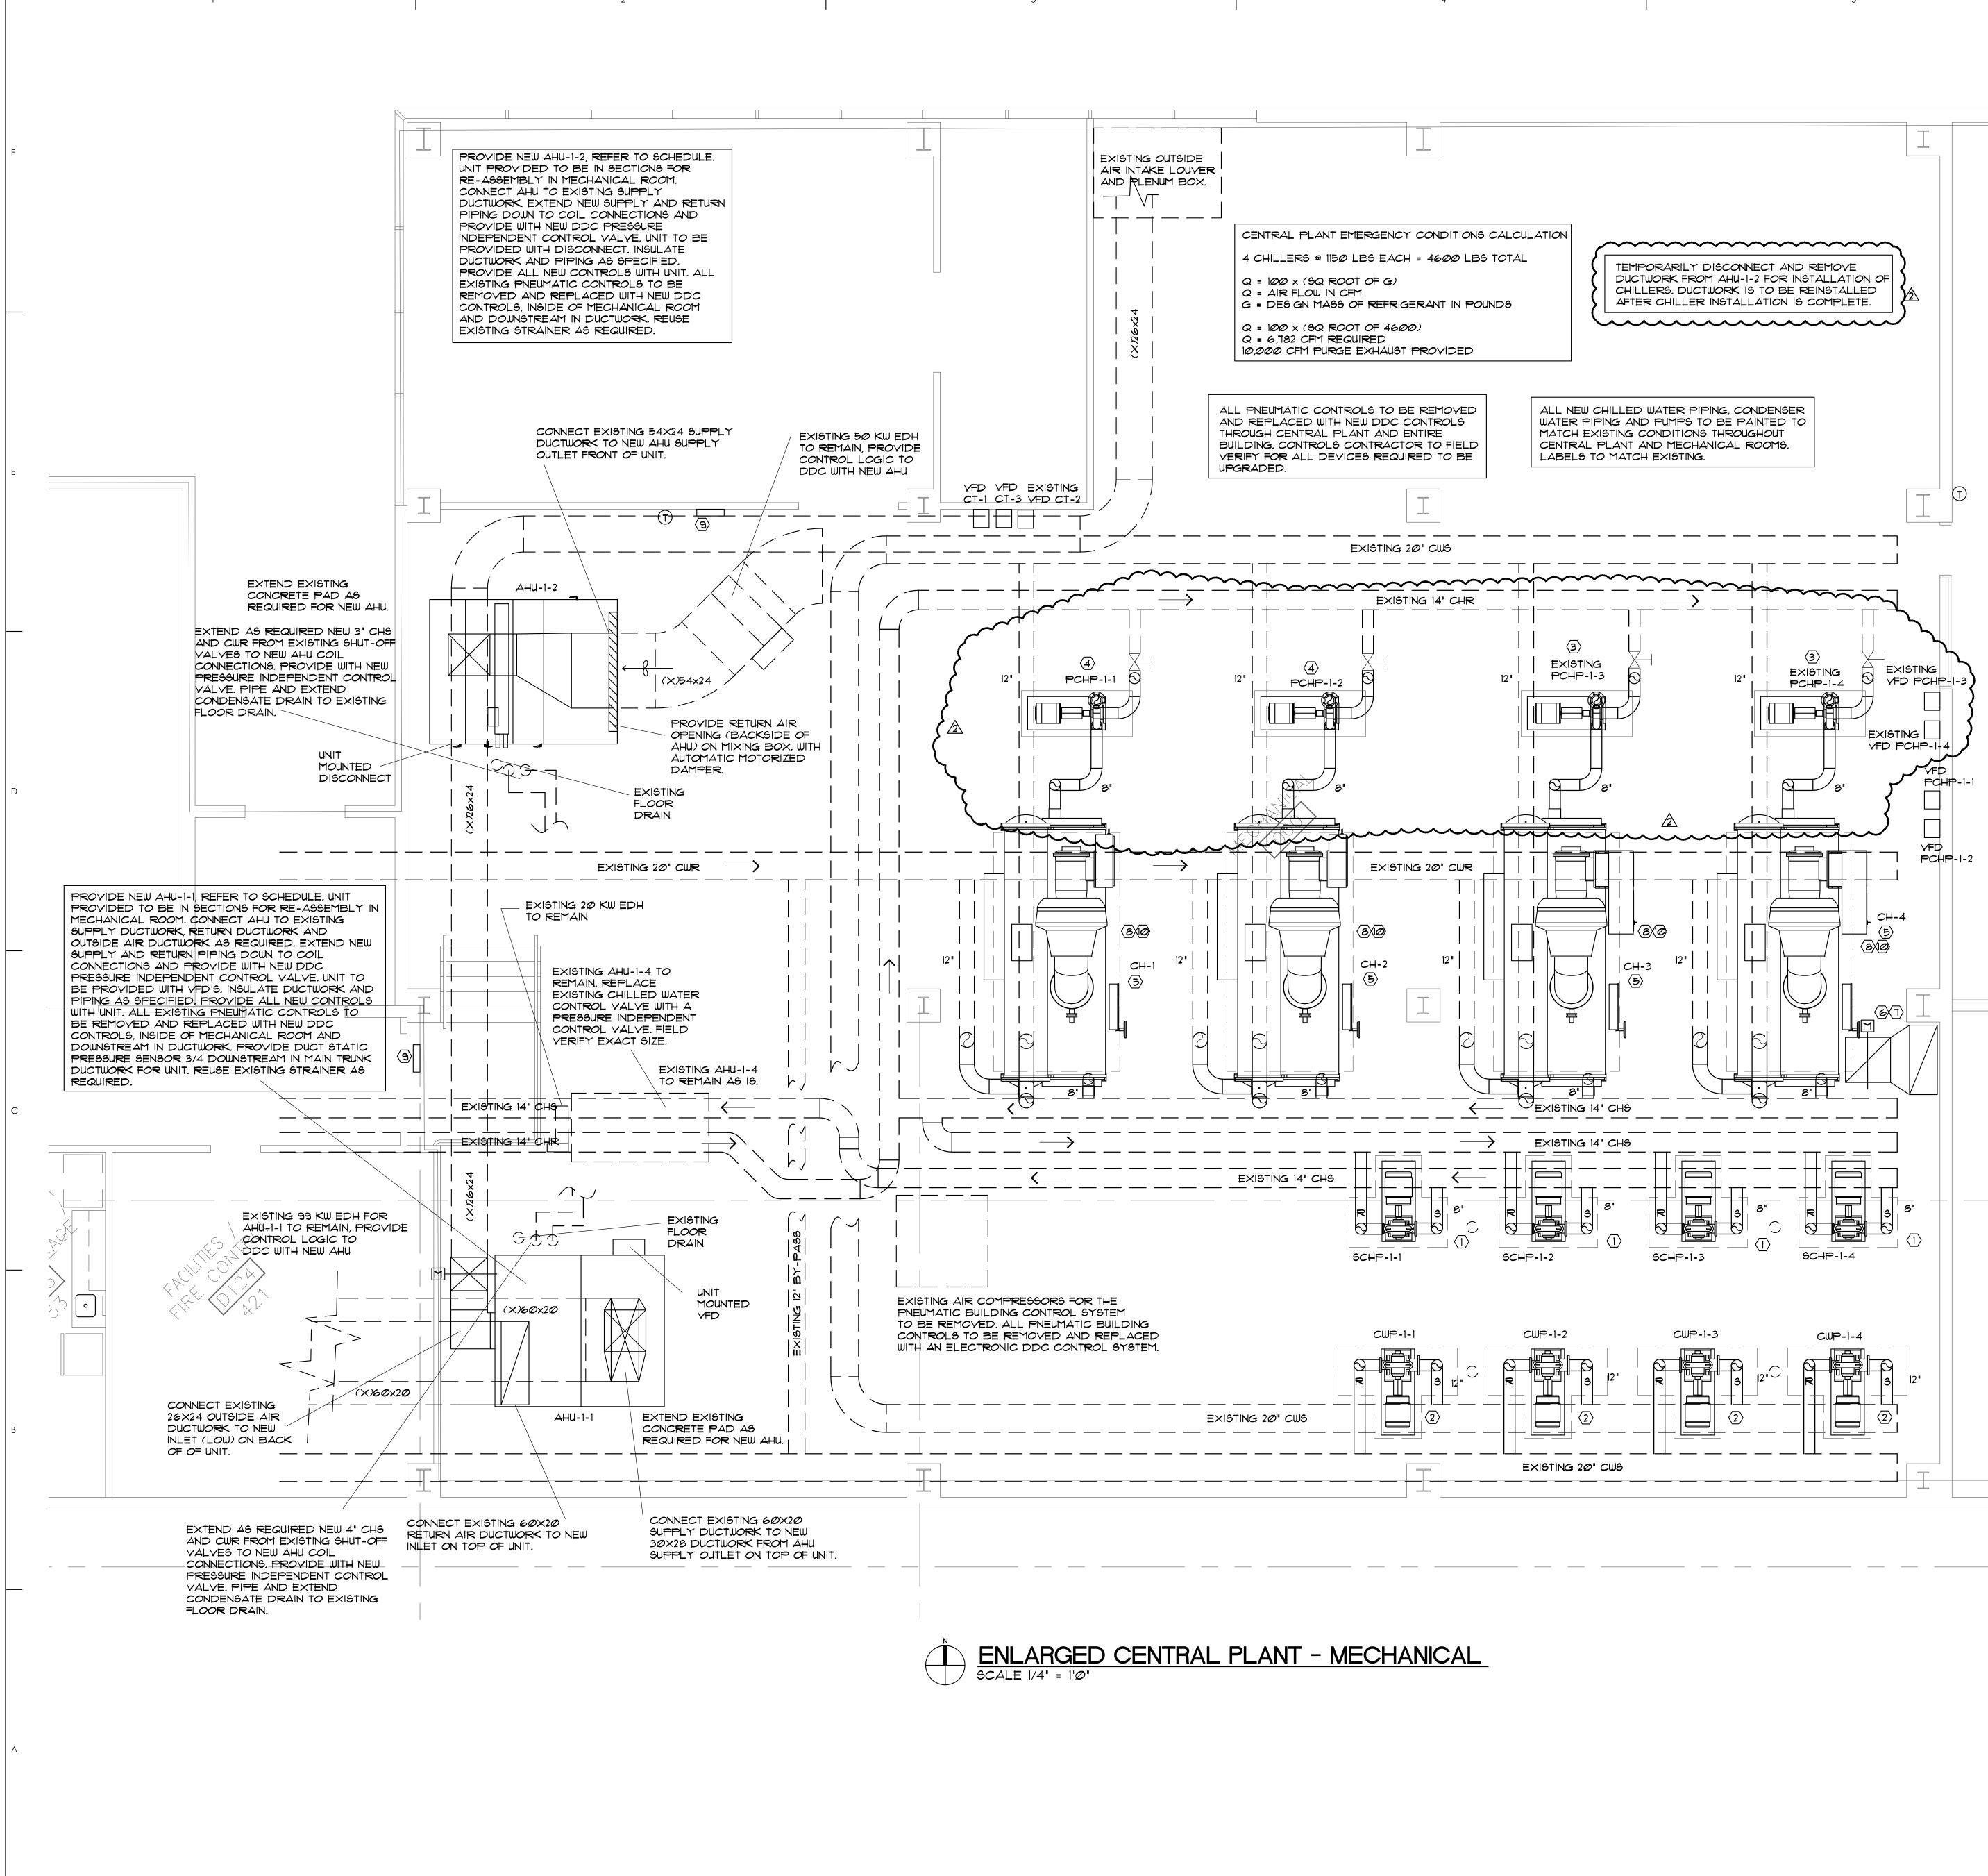

MECHANICAL KEYED NOTES:


- (1) PROVIDE NEW SECONDARY CHILLED WATER PUMP WITH DDC CONTROL VALVING AND RECONNECT TO EXISTING 8" PIPING REQUIRED. PROVIDE ANY OFFGETS AND REDUCERS AS REQUIRED FOR RECONNECTION. INSULATE AS SPECIFIED/MATCH EXISTING. MODIFY CONCRETE PUMP BASE AS REQUIRED FOR NEW PUMP. PROVIDE WITH NEW VFD.
- $\langle 2 \rangle$ provide New Condenser water pump with DDC control VALVING AND RECONNECT TO EXISTING 12" PIPING AS REQUIRED. PROVIDE ANY OFFSETS AND REDUCERS AS REQUIRED FOR RECONNECTION, MODIFY CONCRETE PUMP BASE AS REQUIRED FOR NEW PUMP.
- (3) EXISTING 15 HP PRIMARY CHILLED WATER PUMP WITH VFD TO BE RECONNECTED AND REINSTALLED AFTER ASSOCIATED CHILLER IS INSTALLED. CONTRACTOR TO FIELD VERIFY REMOVAL AND REINSTALLATION REQUIREMENTS OF PUMPS AND PUMP PADS.
- $\langle 4 \rangle$ NEW 15 HP PRIMARY CHILLED WATER PUMP WITH VFD, REFER TO SCHEDULE. PROVIDE WITH 8" CONCRETE BASE. INSULATE AS SPECIFIED/MATCH EXISTING.
- (5) PROVIDE NEW WATER COOLED CHILLER, REFER TO SCHEDULE. EXTEND AND CONNECT EXISTING CHILLED WATER AND CONDENSER WATER PIPING TO NEW CHILLER WITH NEW DDC PRESSURE INDEPENDENT CONTROL VALVING AS REQUIRED. CHILLER REPLACEMENT TO BE PHASED. CHILLERS ARE TO BE DISASSEMBLED BY UNIT MANUFACTURER AND REASSEMBLED ON SITE IN CENTRAL PLANT BY UNIT MANUFACTURER AS REQUIRED FOR INSTALLATION. RIGGING BY MECHANICAL CONTRACTOR. MECHANICAL CONTRACTOR TO FIELD VERIFY ALL EXISTING CONDITIONS OF CHILLED WATER PIPING AND CONDENSER WATER PIPING TO EXISTING CHILLERS PRIOR TO BID. EXTEND, OFFSET, PROVIDE REDUCERS TO NEW CHILLED AND CONDENSER WATER PIPING FROM EXISTING POINTS OF TERMINATION TO NEW CONNECTIONS AT CHILLER AS REQUIRED FOR A COMPLETE AND FUNCTIONING SYSTEM. EXTEND EXISTING CONCRETE PAD AS REQUIRED FOR NEW CHILLER INSTALLATION.
- 50x20 DOWN TO 12" A.F.F. BOTTOM END OF DUCT TO BE LEFT OPEN WITH BIRD SCREEN OVER OPENING.
- (7) 36x36 UP TO EF-1 ON ROOF. EF-1 TO BE INTERLOCK WITH EMERGENCY PURGE VENTILATION SYSTEM. (B) PROVIDE REFRIGERANT DETECTOR VULCAIN MODEL
- 301RFS (REFRIGERANT HCFC-123) OR EQUAL AT CHILLER AND MOUNT PER MANUFACTURER'S RECOMMENDATIONS. (9) PROVIDE MAIN CONTROLLER VULCAIN MODEL 301EM-20
- OR EQUAL, PROVIDE WITH RELAY AND SENSOR WIRING TO AND FROM ALL EQUIPMENT FOR DEACTIVATION OF EQUIPMENT IN THE EVENT OF A GAS DETECTION, PROVIDE COMPLETE DETECTION SYSTEM FOR RELAY INTLERLOCKED TO EF-1, VISUAL ALARM INSIDE AND OUTSIDE OF PLANT (ALERT BEACON) AND AUDIBLE ALARM INSIDE AND OUTSIDE OF PLANT (ALARM HORN), DETECTION SYSTEM TO COMPLY WITH ASHRAE 15 AND INTERFACED INTO MAIN BAS SYSTEM, PROVIDE ALARM LEVELS OF LOW: 50 PPM AND HIGH: 150 PPM. PROVIDE WARNING SIGNS AND SELF CONTAINED BREATHING APPARATUS TO COMPLY WITH ASHRAE 15.
- PROVIDE AND PIPE NEW 3" REFRIGERANT OVERFLOW FROM SUCTION ELBOW NEXT TO COMPRESSOR ON CHILLER UP THROUGH THE ROOF AND GOOSENECK AS REQUIRED. INSTALL PER MANUFACTURER'S RECOMMENDATIONS.

MECHANICAL SYMBOLS


АНИ	AIR HANDLING UNIT
ACC	AIR COOLED CHILLER
ACCU	AIR COOLED CONDENSING UNIT
CD	CONDENGATE DRAIN
DB	DRY BULB
EF	EXHAUST FAN
FCU	FAN COIL UNIT
FD	FIRE DAMPER
F	FAHRENHEIT DEGREE
FLEX	FLEXIBLE CONNECTION
GPM	GALLONS PER MINUTE
HWS	HEATING WATER SUPPLY
HWR	HEATING WATER RETURN
HР	HORSE POWER
MVD	MANUAL VOLUME DAMPER
MUU	MAKE UP AHU
ОА	OUTSIDE AIR
OBD	OPPOSED BLADE DAMPER
RA	RETURN AIR
RH	RELATIVE HUMIDITY
RTU	ROOFTOP A/C UNIT
SA	SUPPLY AIR
Sm	SMOKE DETECTOR
SP	STATIC PRESSURE
SPEC	SPECIFICATION
+~~~	

- TYP WΒ
 - TYPICAL WET BULB

<u>Key Map</u>

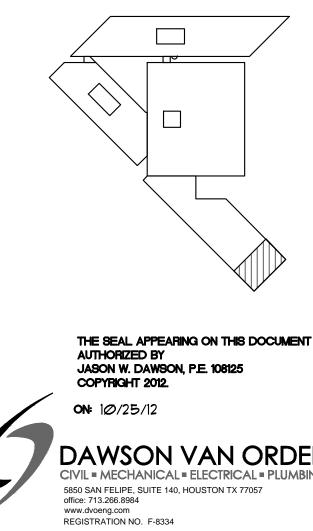

	PROZIGN
F	A R C H I T E C T S 701 Shepherd, Suite 200 Houston, TX 77007 P (713) 977-6060 F (713) 977-6086 CONSULTANTS: MEP&T: DAWSON VAN ORDEN 5850 SAN FELIPE ST. SUITE 140 HOUSTON, TX 77057
	T 713-266-8984 F 713-266-1238
E	HOUSTON COMMUNITY COLLEGE 2811 Hayes Rd. Houston, TX 77082
D	
С	
	10-25-2012 ADDENDUM NO. CHEVRON 2 2 10-17-2012 ISSUED FOR BID 10-09-2012 ISSUED FOR PERMIT
	DELTA# DATE DESCRIPTION PROFESSIONAL SEALS
В	JASON W. DAWSON TO8125 SONAL ENSE
	FILENAME MECHANICAL NEW.dwg
	JOB ABBREV. DRAWN BY WD CHECKED BY JWD JOB NO. 1397 SCALE 1/4'' = 1'-0''
	DATE 10-09-2012 ISSUE ISSUED FOR BID SHEET CONTENTS
was A	ENLARGED PLANS
N IG	DRAWING NUMBER

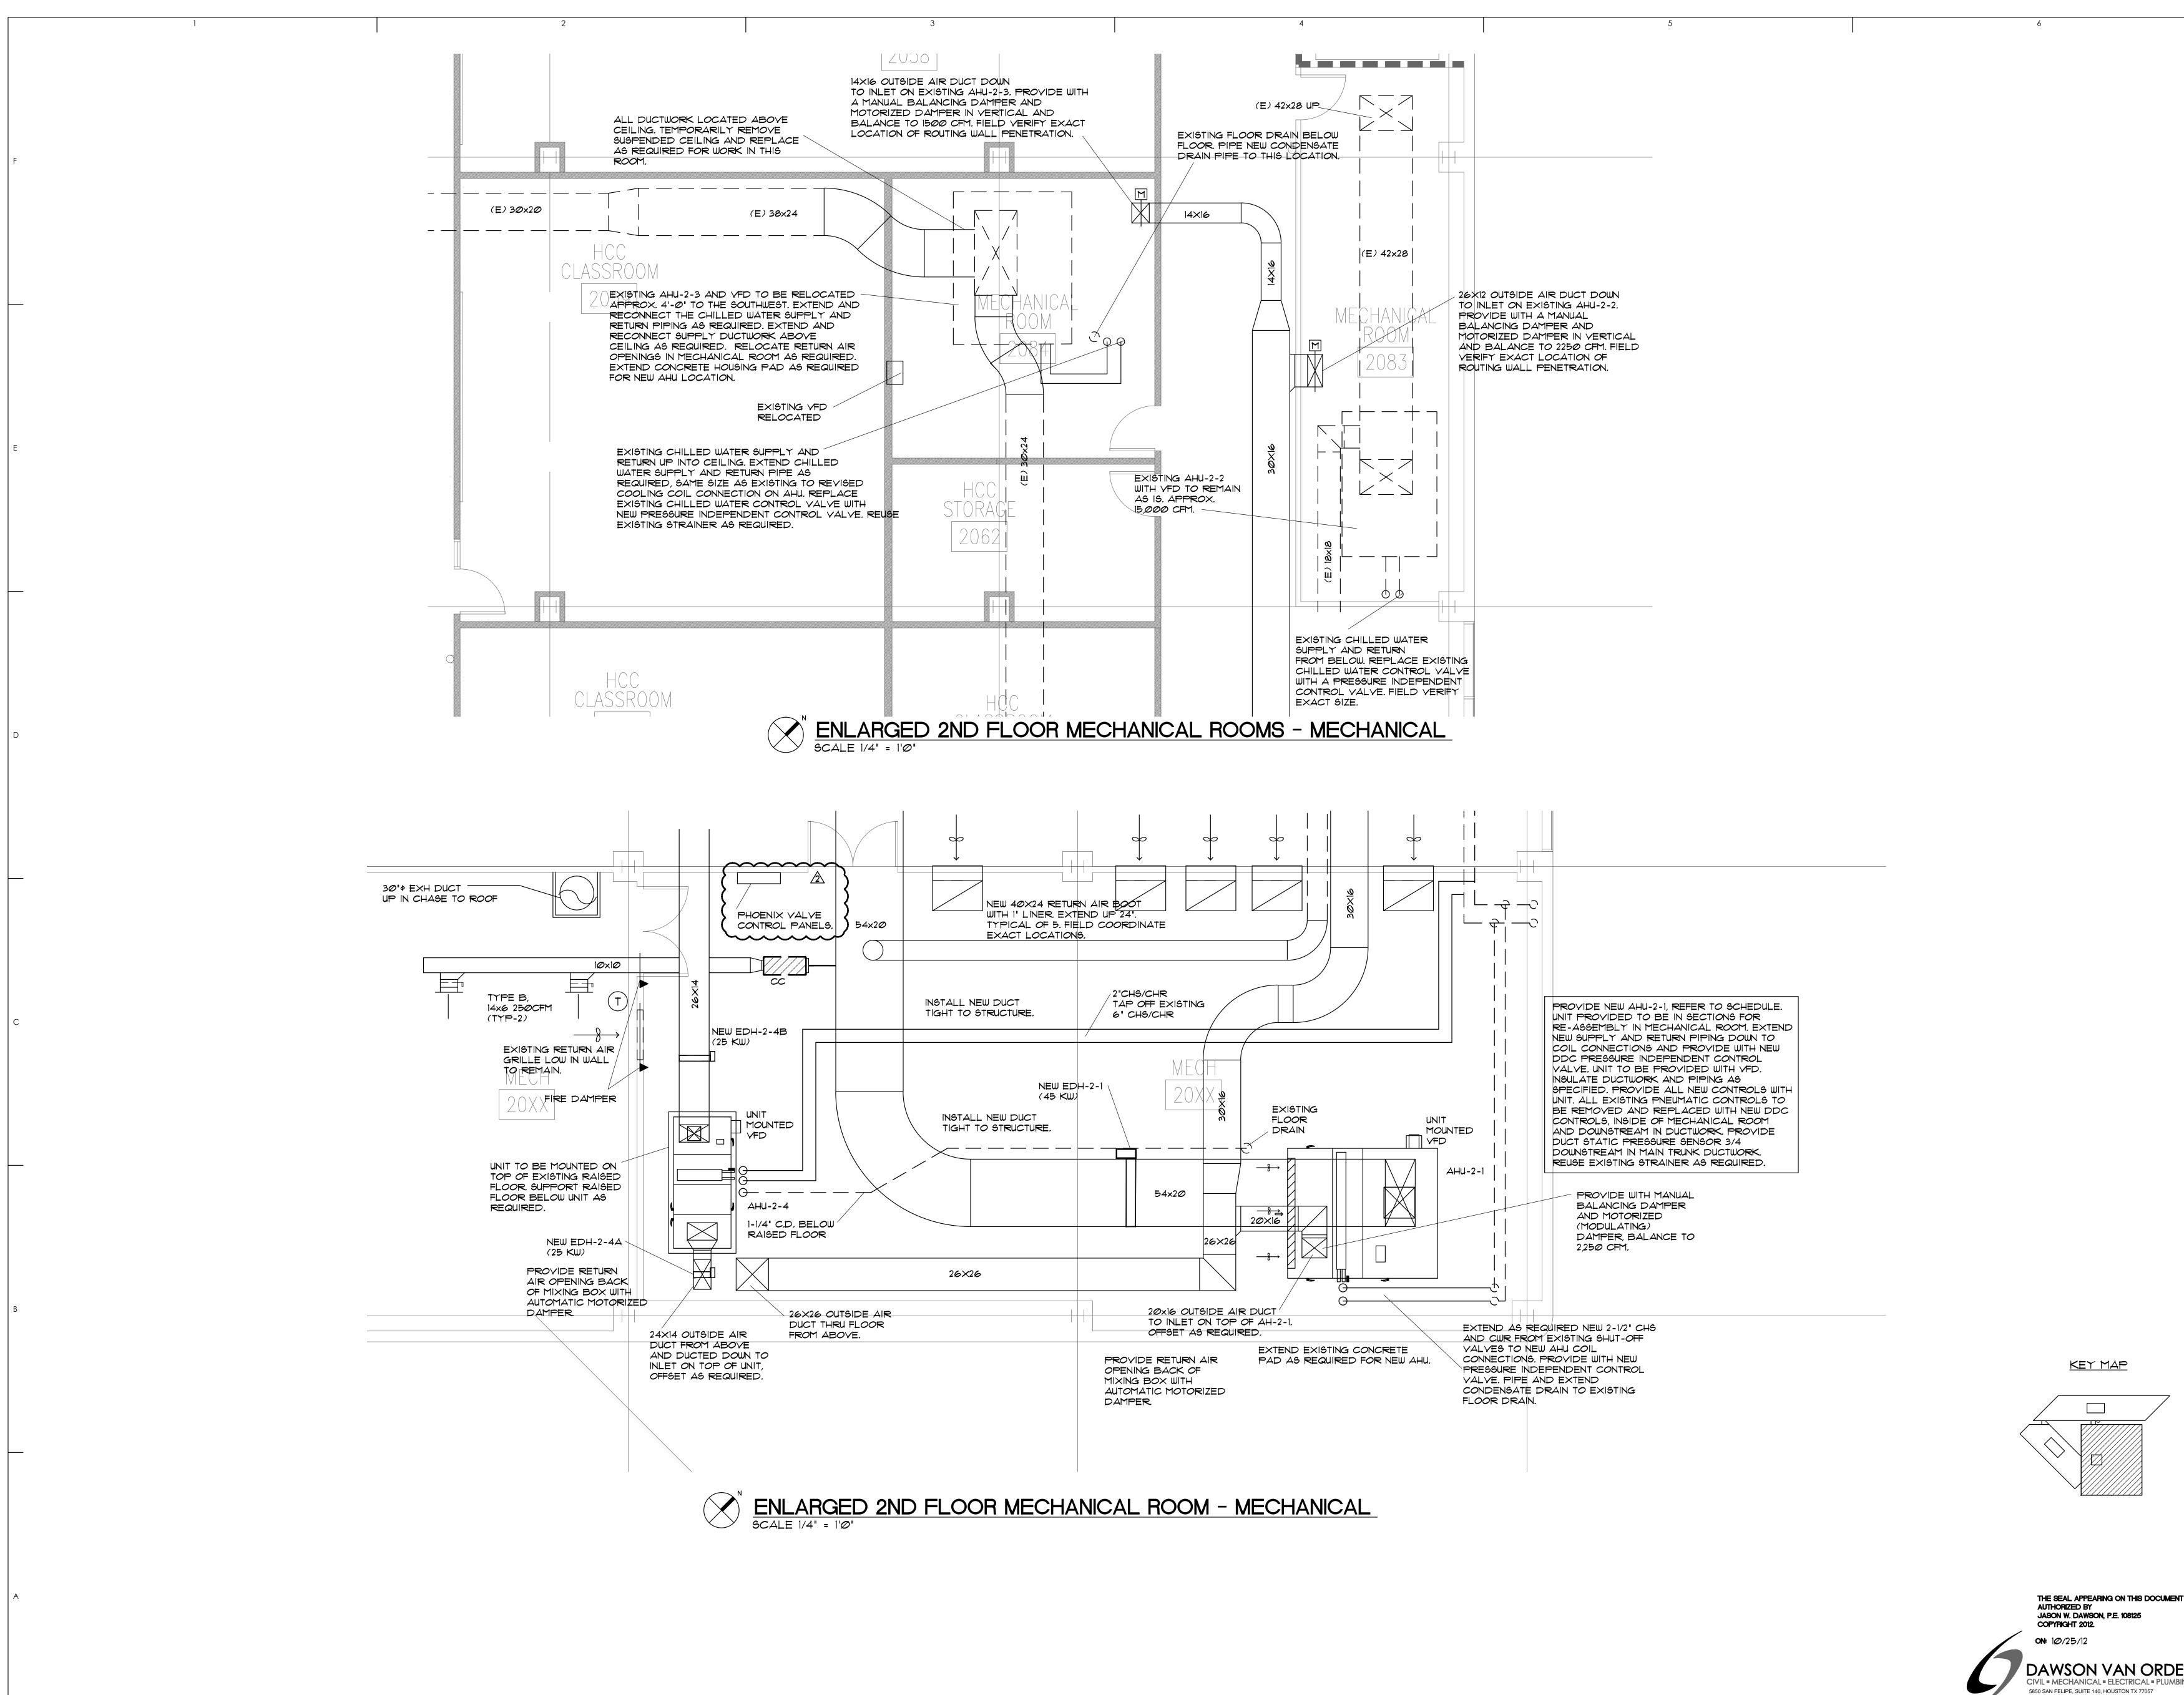

DAWSON VAN ORDE CIVIL = MECHANICAL = ELECTRICAL = PLUMBIN office: 713.266.8984 www.dvoeng.com **REGISTRATION NO. F-8334**

	PROZIGN
	A R C H I T E C T S 701 Shepherd, Suite 200 Houston, TX 77007 P (713) 977-6060 F (713) 977-6086
	F MEP&T: DAWSON VAN ORDEN 5850 SAN FELIPE ST. SUITE 140 HOUSTON, TX 77057
	T 713-266-8984 F 713-266-1238 Client:
_	
	HOUSTON COMMUNITY COLLEGE 2811 Hayes Rd. Houston, TX 77082
-	
	D
-	
	С
_	
	10-25-2012 ADDENDUM NO. CHEVRON 2 2 10-17-2012 ISSUED FOR BID 10-09-2012 ISSUED FOR PERMIT
	DELTA# DATE DESCRIPTION PROFESSIONAL SEALS B
	JASON W BAWSON 108125 CENSED CONAL ENGINE
-	FILENAME MECHANICAL NEW.dwg JOB ABBREV.
	DRAWN BY WD CHECKED BY JWD JOB NO. 1397 SCALE 1/4" = 1'-0" DATE 10-09-2012 ISSUE ISSUED FOR BID
WA 6	SHEET CONTENTS ENLARGED PLANS
VAS	
G	
	M.408

MECHANICAL KEYED NOTES:

2

3

 $\langle 1 \rangle$ NEW FAN POWERED VAV BOX, REFER TO SCHEDULE. $\langle 2 \rangle$ NEW LAB HOOD. SOUCH. PROVIDE WITH S" DUCT TO OUTDOOR. PROVIDE WITH PHOENIX CONTROLS INTERLOCKED INTO BAS SYSTEM. $\langle 3 \rangle$ NEW VAV BOX. REFER TO SCHEDULE.

MECHANICAL SYMBOLS

AHU ACC ACCU DD EF ECU ED	AIR HANDLING UNIT AIR COOLED CHILLER AIR COOLED CONDENSING UNIT CONDENSATE DRAIN DRY BULB EXISTING ITEM TO REMAIN EXHAUST FAN FAN COIL UNIT FIRE DAMPER FAHRENHEIT DEGREE
LEX	FLEXIBLE CONNECTION
GPM	GALLONS PER MINUTE
HWS	HEATING WATER SUPPLY
IWR	HEATING WATER RETURN
	HORSE POWER
- 17D	MANUAL VOLUME DAMPER
144	MAKE UP AHU
0A	OUTSIDE AIR
OBD	OPPOSED BLADE DAMPER
RA	RETURN AIR
RH	RELATIVE HUMIDITY
RTU	ROOFTOP A/C UNIT
ЗА	SUPPLY AIR
3m	SMOKE DETECTOR
3P	STATIC PRESSURE
BPEC	SPECIFICATION
ΥP	TYPICAL
UB	WET BULB
	FIRE DAMPER
◀──	R/A OPENING
	VERIFY SIZE ON
	FLOOR PLAN.

1

V	VAV BOX SCHEDULE									
TYPE VAV-	OLING COLINA CINA COLINA CINA CINA CINA CINA CINA CINA CINA C	INLET (IN)		MANUFACTURER						
ДД	23Ø	4"		CARRIER 35E						
BB	360	5"		CARRIER 35E						
CC	52Ø	6"		CARRIER 35E						
DD	DIF	, , , , , , , , , , , , , , , , , , , 		CARRIER 35E						
EE	925	8'		CARRIER 35E						
FF	1200	9"		CARRIER 35E						
GG	1450	10"		CARRIER 35E						
HH	2100	12 "		CARRIER 35E						

4

1. VAV BOXES TO BE BALANCED TO CFM LEVEL REQUIRED BY DIFFUSERS IN ZONE

N POWI	ERED P	ARAL	LEL	VAV B	OX S
COOLING CFM	HEATING CFM	FAN HP	FAN SP	INLET (IN)	, ₩ 100
515	400	1/10	.25	6"	2-
92Ø	400	1/10	.25	8"	2-
920	600	1/10	.25	8"	2-
1430	600	1/10	.25	10"	2 ⁻ 2 ⁻
1430	1050	1/4	.25	10"	2
2060	1050	1/4	.25	12 "	2-
2060	1500	1/2	.25	12"	2-
2800	1500	1/2	.25	14"	2-
2800	1800	1/2	.25	14"	2
	COOLING FM 920 920 1430 1430 2060 2060 2800	COOLING HEATING CFM CFM 515 400 920 400 920 600 1430 600 1430 1050 2060 1500 2800 1500	COOLING HEATING FAN CFM CFM HP 515 400 1/10 920 400 1/10 920 600 1/10 1430 600 1/10 1430 1050 1/4 2060 1500 1/2 2800 1500 1/2	COOLING HEATING CFM FAN HP FAN SP 515 400 1/10 .25 920 400 1/10 .25 920 600 1/10 .25 920 600 1/10 .25 1430 600 1/10 .25 1430 1050 1/4 .25 2060 1050 1/4 .25 2060 1500 1/2 .25	CFM HP SP (IN) 515 400 1/10 .25 6" 920 400 1/10 .25 8" 920 600 1/10 .25 8" 920 600 1/10 .25 8" 1430 600 1/10 .25 10" 1430 1050 1/4 .25 10" 2060 1050 1/4 .25 12" 2060 1500 1/2 .25 12" 2800 1500 1/2 .25 14"

 VAV BOXES TO BE BALANCED TO CFM LEVEL REQUIRED BY DIFFUSERS IN ZONE
 ALL UNITS PRESSURE DEPENDANT.

4. ALL MOTORS ECM TYPE. 5. REFER TO PLANS FOR ACCESS CONNECTION SIDE.

MARK	DESCRIPTION	RADIATION DAMPER	OBD DAMPER	MANUFACTURER TITUS, UNLESS NOTED
А	CEILING DIFF	NO	NO	OMNI-AA, SQUARE PLAQUE LAY-IN
в	SIDE WALL	NO	YES	300FS, DBL. DEFLEC., VERT. FRONT
С	RETURN AIR	NO	NO	PAR-AA, PERFORATED FACE LAY-IN
D	EXHAUST	NO	YES	350FL, SURFACE MOUNT
E	SUPPLY	NO	YES	ML-38 SUPPLY SLOT DIFFUSER
F	RETURN	NO	NO	MLR-38 RETURN AIR SLOT REGISTER

VERIFY ALL CEILING TYPES WITH ARCHITECTURAL DRAWINGS. ALL AIR DEVICES SHALL BE ALUMINUM, UNLESS NOTED. SUPPLY RADIATION DAMPERS FOR DEVICES PENETRATING RATED CEILINGS. SUFFLIT RADIATION DATIFERS FOR DEVICES FENETRATING RATED CEILINGS.
 VERIFY FINAL COLOR/FINISH WITH ARCHITECT FOR ALL DIFFUSERS AND GRILLES.
 VERIFY FINAL COLOR/FINISH WITH ARCHITECT FOR ALL LOUVERS.
 PROVIDE TYPE E WITH INSULATED PLENUM ON TOP OF SLOT DIFFUSER SIZED FOR LENGTH AND WIDTH OF DIFFUSER.

										,
FUN										
MARK	LAB * CONSTANT BENCH TOP LENGTH CONNECTION MANUFACTURER									R
₽ ₩-1	WET CHEM	CONSTANT	BENCH TOP	° 4	800	(1) -	14"	MOTT-V		SASH X
1. BENCH TOP FUME HOODS TO BE SET AT 28-1/2' HEIGHT VERTICAL MAX. SASH OPENING. 2. PROVIDE LOW FLOW ALARMS AS REQUIRED AND INTEGRATED INTO BAS. FUME HOOD EXHAUST FAN SCHEDULE - ROOF MOUNTED										
MARK SERVICE CFM STATIC FAN DRIVE VOLT HP MANUFACTURER										
EF-2	WET CHE	M HOOD	6400		2.5	123Ø	BELT	460/3	5	GREENHECK SWB-224
EE-3	WET CHE	MHOOD	6400		2.5	1230	BELT	460/3	5	GREENLIECK GUR-224

		0400		12 290				GREENHECK SUB-224					
EF-3	WET CHEM HOOD	6400	2.5	1230	BELT	460/3	5	GREENHECK SWB-224					
1. E×	1. EXHAUST FAN #2 SHALL BE INTERLOCKED WITH NEW AHU 2-4.												
2. EX	HAUST FAN #3 (STAND	BY) SHALL	BE INTERLOCKE	D WITH N	EW AHU 2-	-4.							
3. PF	ROVIDE 2 SPEED FAN	WHICH OPE	ERATES 100% DUR	ING OCC	UPIED TIM	1E AND 50	% DURIN	NG UN-OCCUPIED TIME.					
$\sim\sim\sim\sim\sim\sim$	~~~~~~~~~~~~~~~~	~~~~~		\sim	~~~~~	~~~~~	\sim		\sim				

ARK	MAX CFM	SUPPLY CFM UNOCCUPIED	RM HOOD MAX CFM EXHAUST	SUPPLY MIN CFM	CFM OFFSET EXHAUST OCCUPIED	CFM OFFSET EXHAUST UNOCCUPIED	MAX PD "WG	SIZE	MANUFACTURER / MODEL
SY-1	945	473	3@800	Ø	1455	ד2ד	Ø.T	SINGLE 10"	PHOENIX CONTROLS - MAVAFI@MAI
S√-2	945	473	3@800	Ø	1455	727	Ø.T	SINGLE 10"	PHOENIX CONTROLS - MAVAFIØMAI
LA	B ROOM AND		IR UNIT. REF	ER TO E>	KHAUST VALV	E SCHEDULE FO		EXHAUST VALV TO BE INTERG	

MARK	EXH. CFM MAX. OCCUPIED	SUPPLY VALVE OFFSET		Ξ ΣΞ ΨΣ υΣ	CFM OFFSET	MAX PD 'WG	SIZE	MANUFACTURER / MODEL
E∨-1	800	S∨-1	400	Ø	***	Ø.7	SINGLE 10"	PHOENIX CONTROLS - EXVBFIØMAM
E∨-2	800	SV-1	400	Ø	***	Ø.1	SINGLE 10"	PHOENIX CONTROLS - EXVBFI@MAM
E∨-3	800	S∨-1	400	Ø	***	Ø.1	SINGLE 10"	PHOENIX CONTROLS - EXVBFIØMAM
E∨-4	800	SV-2	400	Ø	***	Ø.1	SINGLE 10"	PHOENIX CONTROLS - EXVBFIØMAM
EV-5	800	SV-2	400	Ø	***	Ø.1	SINGLE 10"	PHOENIX CONTROLS - EXVBFI@MAM
EV-6	800	S∨-2	400	Ø	***	Ø.1	SINGLE 10"	PHOENIX CONTROLS - EXVBFIØMAM
EV-1	800		400	Ø	***	Ø.1	SINGLE 10"	PHOENIX CONTROLS - EXVBFIØMAM
EV-8	800		400	Ø	***	Ø.7	SINGLE 10"	PHOENIX CONTROLS - EXVBRIGMAM

EXHAUST AIR VALVE TO BE INTEGRATED AND CONTROLLED WITH EXHAUST HOOD AND SUPPLY VALVE WITHIN 1. LAB ROOM AND MAKE-UP AIR UNIT, REFER TO SUPPLY AIR VALVE SCHEDULE. MAINTAIN OFFSET AS SCHEDULED FOR NEGATIVE ROOM PRESSURE. 2. 3. COORDINATE ALL CONTROL FEATURES OF EXHAUST AIR VALVE PRIOR TO ORDERING. 4. *** REFER TO SUPPLY AIR VALVE SCHEDULE FOR CFM OFFSET TO BE MAINTAINED. PROVIDE H2S EQUIVALENT COATING OR COATING REQUIRED BASED UPON CHEMICALS EXHAUSTED FOR EACH VALVE. 5.

6. PROVIDE FLOW ALARM ON NEW FUME HOOD THAT IS COMPATIBLE WITH FUME HOOD INTERGRATE TO CONTROL SYSTEM. ALARMS TO MONITOR FUME HOOD AND MAINTAIN REQUIRED CFM FLOW PER ~~~~ EXHAUGT-VALXE-SCHEDULE-IF-FLOULRANGE-AND-VELOCITY-ARE-OUT-OF-REQUIRED-RANGE-ALARM-SHALL-SOUND AND

AND MAIN CONTROL SYSTEM TO BE ALERTED. EXHAUST VALVES TO BE PROVIDED WITH AUXILIARY INPUTS. PROVIDE WITH CONTROL PANELS AS REQUIRED FOR A COMPLETE AND FUNCTIONING SYSTEM. V 4 \

F	FAN AND COIL UNIT SCHEDULE													
MARK	CHI	ILLED	WATER CO		FAN			HEATING	MIN. CK				MANUFACTURER	
	SUPPLY	OA	TOTAL	SEN	HP STATIC V	VOLTS	KW	AMPS	MOCP	GPM				
	CFM	CFM	BTUH	BTUH		PRESS	PHASE							
FCU-1-9	35Ø	40	10,124	8,726	.25	1.00	2Ø8/1	1.5	8,9	ы	1,5		CARRIER 4200KN-12	


SELECTIONS OR BASED ON EWT/LWT 42/56F. 1. 2. PROVIDE WITH PRESSURE INDEPENDENT CONTROL VALVE FOR EACH UNIT.

4

3. UNITS SHALL BE SUSPENDED FROM STRUCTURE



SCHEDULE HEATING VOLTS MANUFACTURER FAN TS PH KW/STAGES PHASE 2.5/1 277/1 CARRIER 45M-2 CARRIER 45M-2 2.5/1 277/1 4/1 CARRIER 45M-3 CARRIER 45M-3 4/1 277/1 CARRIER 45M-3 277/1 CARRIER 45M-4 277/1 CARRIER 45M-4 277/1 CARRIER 45M-5 277/1 CARRIER 45M-5 ٦/2 10/2 10/2 211/1 CARRIER 45M-5 11.5/2 211/1 CARRIER 45M-6

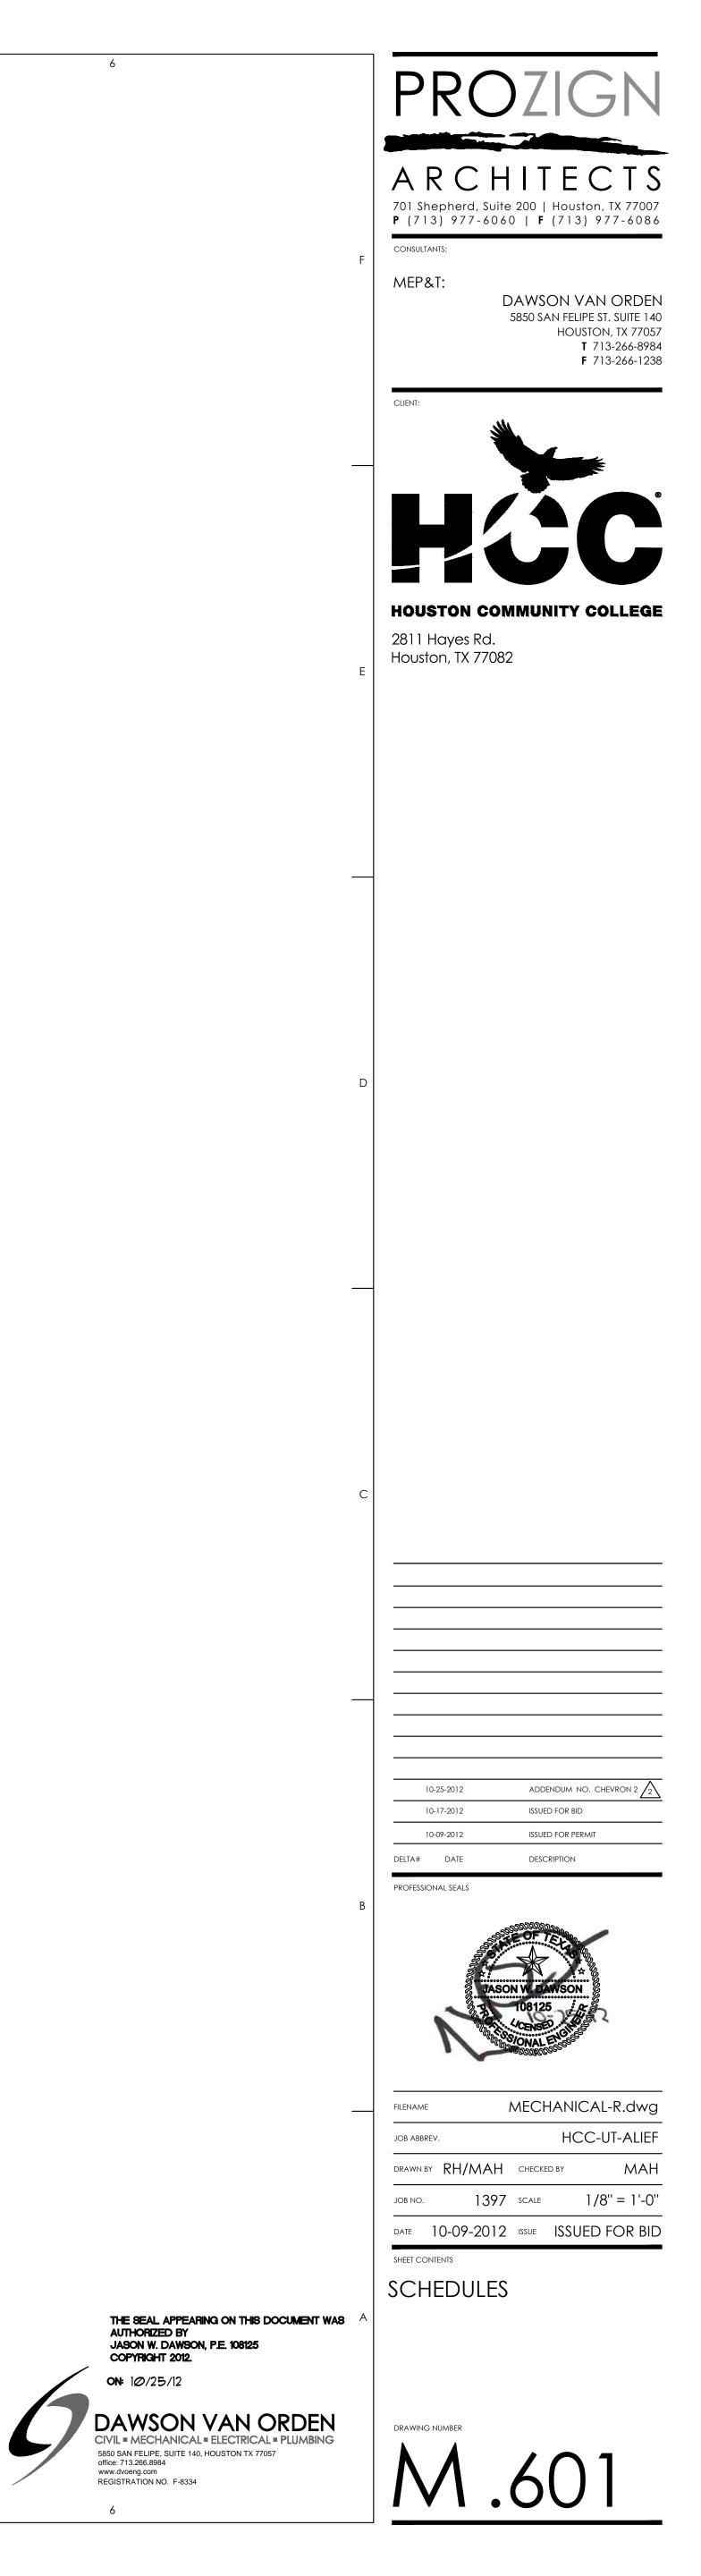



October 31, 2012

Chevron Energy Solutions Company A Division of Chevron U.S.A. Inc. 12980 Foster, Suite 400 Overland Park, KS 66213-2649 Tel: 913-748-8800 Fax: 913-748-8734

ADDENDUM – Chevron-3

FROM: Chevron Energy Solutions Company

TO: Prospective Bidders

RE: Addendum – Chevron-3 to Houston Community College – Alief Center Renovation

You are instructed to read and to note the following described changes, corrections, clarifications, approvals, additions, and/or deletions.

Receipt of Addendum - Chevron-3 is to be acknowledged on the bid form by the Bidder.

CHANGES/CLARIFICATIONS

- 1) Section 23 64 16, Part 1 GENERAL, Article 1.9 WARRANTY shall be replaced with:
 - A. See Section 01 77 00 Closeout Procedures, for additional warranty requirements.
 - B. Provide a one year warranty for parts, labor, and refrigeration from date of issuance of occupancy permit. Warranty to coincide with manufacturer's parts warranty.
 - C. Provide second through fifth year parts warranty on compressors.
- 2) All supply ductwork to be externally wrapped.
- 3) TDF/TDC duct flange is acceptable for rectangular fume hood ductwork, mig welded joints are acceptable for round fume hood ductwork.
- 4) Painting specified on Sheet M.406 shall be by Bidder.
- 5) New equipment pads required for mechanical work shall be provided and installed by Bidder.
- 6) Bidder shall provide list of any electrical support required for temporary setups.
- 7) Original structural drawing S1 is included for reference.
- Bid Due Date shall be revised. Bids will be received by 1:00 p.m. (local time) Friday, November 2nd, 2012.